


STATE OF KANSAS  
STATE CORPORATION COMMISSION

WELL PLUGGING RECORD

Give All Information Completely  
Make Required Affidavit  
Mail or Deliver Report to  
Conservation Division  
State Corporation Comm.  
245 North Water  
Wichita, KS 67202

Haskell County. Sec. 36 Twp. 27S Rge. 31W E/W  
Location as "NE/CNW $\frac{1}{4}$ SW $\frac{1}{4}$ " or footage from lines  
1320' FNL & 1320' FWL

Lease Owner Texas Oil & Gas Corp.  
Lease Name Moore "B" Well No. 1  
Office Address 200 W. Douglas Suite 300 Wichita, Kansas 67202  
Character of Well (Completed as Oil, Gas or Dry Hole) \_\_\_\_\_

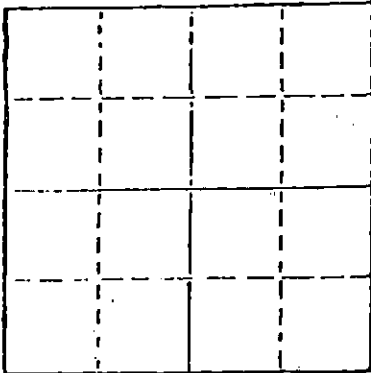

Locate well correctly on above  
Section Plot

Dry Hole  
Date Well completed \_\_\_\_\_ 19\_\_\_\_  
Application for plugging filed 5-2 1978  
Application for plugging approved 5-5 1978  
Plugging commenced 6-1 1978  
Plugging completed 6-3 1978  
Reason for abandonment of well or producing formation \_\_\_\_\_

Dry  
If a producing well is abandoned, date of last production \_\_\_\_\_ 19\_\_\_\_

Was permission obtained from the Conservation Division or its agents before plugging was commenced? Yes

Name of Conservation Agent who supervised plugging of this well Clarence Thomas  
Producing formation \_\_\_\_\_ Depth to top \_\_\_\_\_ Bottom \_\_\_\_\_ Total Depth of Well 3000

Show depth and thickness of all water, oil and gas formations.

OIL, GAS OR WATER RECORDS

CASING RECORD

FORMATION	CONTENT	FROM	TO	SIZE	PUT IN	PULLED OUT
				8 5/8	695	none
				4 1/2	2985	1710

Describe in detail the manner in which the well was plugged, indicating where the mud fluid was placed and the method or methods used in introducing it into the hold. If cement or other plugs were used, state the character of same and depth placed, from \_\_\_\_\_ feet to \_\_\_\_\_ feet for each plug set.

Pump 20 sks. of cement from 2921 to 2600

Pump 35 sks. of cement from 600 to 500

Put 10 sks. of cement from 40 to 0

RECEIVED  
STATE CORPORATION COMMISSION

JUN 28 1978

CONSERVATION DIVISION  
Wichita, Kansas

(If additional description is necessary, use BACK of this sheet)

Name of Plugging Contractor Sargent's Casing Pulling Ser. Kansas No. 511  
Box 506 Liberal, Kansas 67901

STATE OF KANSAS COUNTY OF SEDGWICK, ss.  
STEPHEN G. TILLMAN of Texas Oil & Gas Corp. (employee of owner) or (owner or operator) of the above-described well, being first duly sworn on oath, says: That I have knowledge of the facts, statements, and matters herein contained and the log of the above-described well as filed and that the same are true and correct. So help me God.

(Signature) [Signature]  
STEPHEN G. TILLMAN - Texas Oil & Gas Corp.  
200 W. Douglas (Address) Suite 300 Wichita,

SUBSCRIBED AND SWORN TO before me this 27 day of June, 1978 KS

[Signature]  
Notary Public.

My commission expires January 23, 1980




MOORE "B" #1

1320' FNL & 1320' FWL

SEC 36-275-31W

HASKELL Co., KS

2839' G.L. & 2844' K.B.

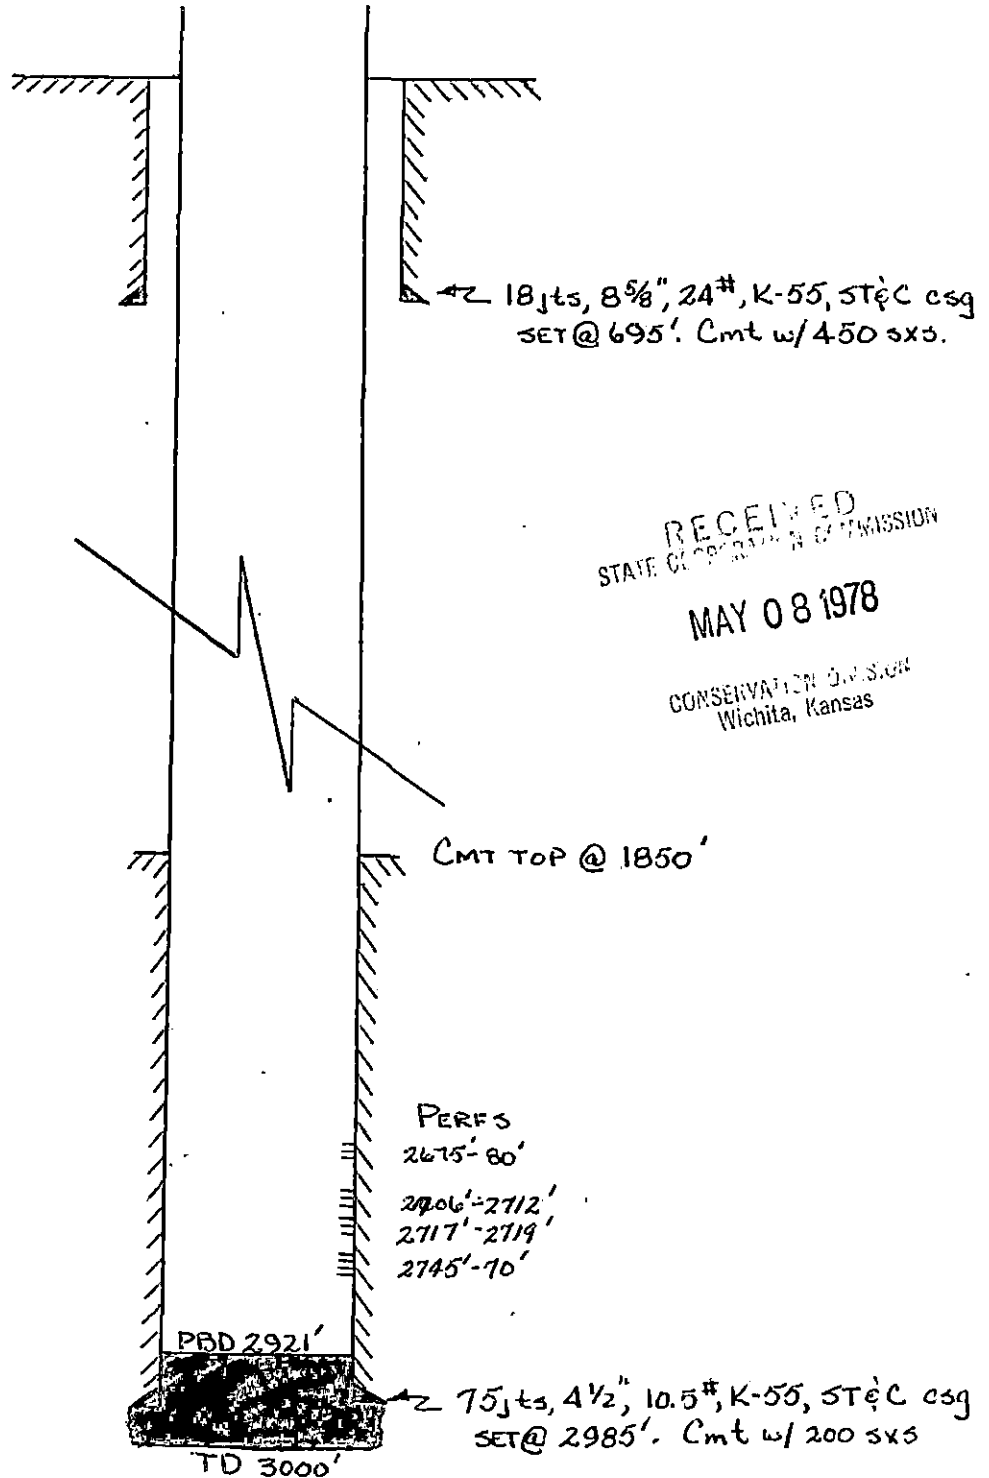

RECEIVED  
STATE COMMISSION  
MAY 08 1978  
CONSERVATION DIVISION  
Wichita, Kansas