


STATE OF KANSAS
STATE CORPORATION COMMISSION

WELL PLUGGING RECORD

Give All Information Completely
Make Required Affidavit
Mail or Deliver Report to
Conservation Division
State Corporation Comm.
245 North Water
Wichita, KS 67202

Ford County. Sec. 25 Twp. 27S Rge. 24 W/W
Location as "NE/CNW 1/4 SW 1/4" or footage from lines _____
NW SW NW
Lease Owner Benson Mineral Group, Inc.
Lease Name Wenke Well No. 1
Office Address 3200 Anaconda Tower, 555 17th St. Denver, CO.
Character of Well (Completed as Oil, Gas or Dry Hole) B0202

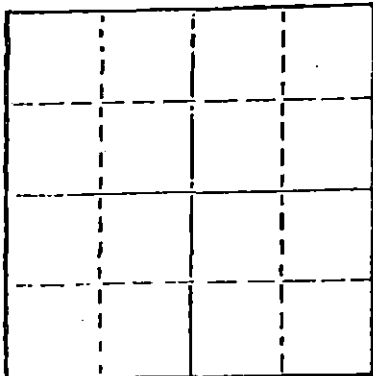

Locate well correctly on above
Section Plot

Date Well completed 9/6/78 19
Application for plugging filed 9/6/78 19
Application for plugging approved 9/6/78 19
Plugging commenced 9/6/78 19
Plugging completed 9/6/78 19
Reason for abandonment of well or producing formation
Dry Hole

If a producing well is abandoned, date of last production
19

Was permission obtained from the Conservation Division or
its agents before plugging was commenced? Yes

Name of Conservation Agent who supervised plugging of this well Clarence Thomas
Producing formation _____ Depth to top _____ Bottom _____ Total Depth of Well 2753'
Show depth and thickness of all water, oil and gas formations.

OIL, GAS OR WATER RECORDS

CASING RECORD

FORMATION	CONTENT	FROM	TO	SIZE	PUT IN	PULLED OUT
	water.			8 5/8"	498'	

Describe in detail the manner in which the well was plugged, indicating where the mud fluid
was placed and the method or methods used in introducing it into the hold. If cement or other
plugs were used, state the character of same and depth placed, from _____ feet to
_____ feet for each plug-set.

Drilling mud to 500', set plug, 50-50 poz mix. ~~drilling mud~~ 50 sx cement.
drilling mud to 40', 10 sx cement, 5 sx cement, rathole, 5 sx cement, mousehole.

(If additional description is necessary, use BACK of this sheet)

Name of Plugging Contractor B & N Drilling, Division of Benson Mineral Group, Inc.

STATE OF KANSAS COUNTY OF MONTGOMERY, ss. contractor
Lucille Shukers (employee of ~~owner~~) or (~~owner~~)
of the above-described well, being first duly sworn on oath, says: That I have knowledge of
the facts, statements, and matters herein contained and the log of the above-described well
as filed and that the same are true and correct. So help me God.

(Signature) Lucille Shukers
Box 846, Independence, Kansas 67301
(Address)

SUBSCRIBED AND SWORN TO before me this 12th day of September, 1978

My commission expires 9/24/78

Jane McNickle
Notary Public.

JANE McNICKLE
NOTARY
PUBLIC

RECEIVED
STATE CORPORATION COMMISSION Montgomery County, Kansas

SEP 25 1978

CONSERVATION DIVISION
Wichita, Kansas