


WELL PLUGGING RECORD

Give All Information Completely
Make Required Affidavit
Mail or Deliver Report to:
Conservation Division
State Corporation Commission
800 Bitting Building
Wichita, Kansas

NORTH

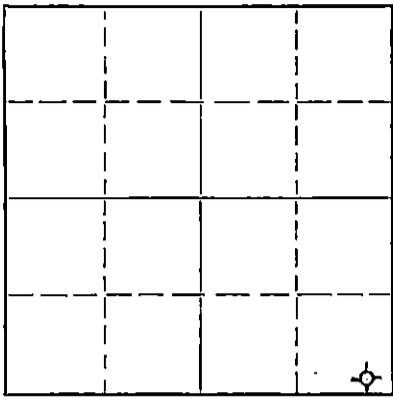

Locate well correctly on above
Section Plat

Sedgwick County. Sec. 35 Twp. 26S. Rge. 1W (E) (W)
Location as "NE/CNW $\frac{1}{4}$ /SW $\frac{1}{4}$ " or footage from lines SE SE SE
Lease Owner A. D. Allison et al
Lease Name Petrie Well No. 1
Office Address 715 Brown Building, Wichita, Kansas
Character of Well (completed as Oil, Gas or Dry Hole)
Date well completed 19 52
Application for plugging filed 4-2 19 52
Application for plugging approved " 19 52
Plugging commenced 3-30 19 52
Plugging completed 3-30 19 52
Reason for abandonment of well or producing formation
Production failed
If a producing well is abandoned, date of last production 19
Was permission obtained from the Conservation Division or its agents before plugging was commenced? Yes

Name of Conservation Agent who supervised plugging of this well D. C. Lilley
Producing formation Depth to top Bottom Total Depth of Well 3404 Feet
Show depth and thickness of all water, oil and gas formations.

OIL, GAS OR WATER RECORDS

CASING RECORD

Formation	Content	From	To	Size	Put In	Pulled Out

Describe in detail the manner in which the well was plugged, indicating where the mud fluid was placed and the method or methods used in introducing it into the hole. If cement or other plugs were used, state the character of same and depth placed, from feet to feet for each plug set.
Cement 3404-3360. Mud 3360 - 175. Rock 175 - 165. Cement 165 to 100.
Mud 100 to 10. Cement 10 to surface.

4-10-52

(If additional description is necessary, use BACK of this sheet)
Name of Plugging Contractor A. D. Allison & Co., Inc.
Address 715 Brown Building, Wichita 2, Kansas.

STATE OF Kansas, COUNTY OF Sedgwick, ss.
J. A. ALLISON (employee of owner) or (owner or operator) of the above-described well, being first duly sworn on oath, says: That I have knowledge of the facts, statements, and matters herein contained and the log of the above-described well as filed and that the same are true and correct. So help me God.

(Signature) *J. A. Allison*
715 Brown Bldg., Wichita 2, Kansas.
(Address)

SUBSCRIBED AND SWORN to before me this 9th day of April, 19 52
Notary Public.

My commission expires July 22, 1953.
23-8390-s 6-51-20M

PLUGGING
FILE SEC 35 T 26 R 1W
BOOK PAGE 6 LINE 15

15-173 of 448 0000

A. D. ALLISON & CO., et al
PETRIE #1

Sec. 35, Twp. 26S., 1W.,
SE SE SE

Total Depth 3404
Comm. 7-26-50 - Comp. 8-8-50
Contractor: A. D. Allison & Co., Inc.

County: Sedgwick

CASING RECORD:

8-5/8" 165'

FORMATION	DEPTH	CABLE TOOL LOG
Sand	55	Perforated one hole 2997 $\frac{1}{2}$ '. One hole 2998'. Filled up 3200' fluid, 200' oil in one hour. Squeezed perforations 22 sacks, displaced behind the pipe. Drilled out to 3400' Lane-Wells measurement. Perforated one hole at 2997, no fluid; one hole 2997 $\frac{1}{2}$, no fluid; one hole at 2998, no fluid; two holes at 2998-1/3'. Hole filled 3000' overnight, 800' oil. After swabbing oil increased and water decreased slightly. Put on pump. Estimated 40 barrels.
Shale	160	
Lime	165	
Shale and shells	235	
Shale and shells and streaks of sand	385	
Shale and shells	475	
Lime	555	
Shale and lime	725	
Sandy lime and shale	810	
Shale	890	
Shale and lime	1035	
Sand	1075	
Shale and shells	1520	
Lime and shale	1665	
Shale and shells	1800	
Lime and shale	1895	
Lime	2090	
Lime and shale	2180	
Lime	2335	
Shale	2605	
Lime	2750	
Shale	2845	
Lime	2875	
Lime and shale	2955	
Shale and lime	3015	
Shale	3050	
Lime	3265	
Lime and shale	3375	
Shale	3395	
Lime	3402	
S. L. M.	3404 T. D.	

TOPS:

Mississippian	3048
Viola	3396

D. S. T. 3399. Open 30 minutes, recovered 1260' oil 1870' water.

Certified true copy of driller's log.

By J. Allison

PLUGGING
 FILE SEC 35 Twp 26S 1W
 BOOK PAGE 6 LINE 15