


WELL PLUGGING RECORD

Give All Information Completely  
Make Required Affidavit  
Mail or Deliver Report to:  
Conservation Division  
State Corporation Commission  
211 No. Broadway  
Wichita, Kansas

NORTH

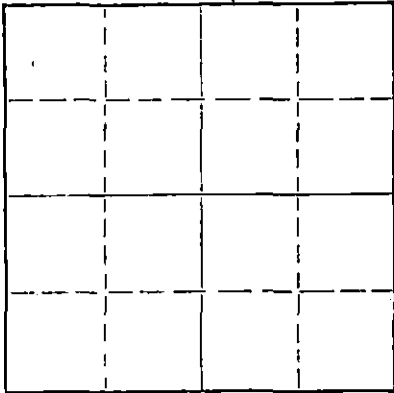

Locate well correctly on above Section Flat

Sedgwick County, Sec. 35 Twp. 26 Rge. 1 ~~1E~~ W (W)  
Location as "NE/CNW/SW" or footage from lines NE NE NW  
Lease Owner Drillers Production Company, Inc.  
Lease Name Petrie Well No. 3  
Office Address Wichita, Kansas  
Character of Well (completed as Oil, Gas or Dry Hole) \_\_\_\_\_  
Date well completed \_\_\_\_\_ 19\_\_\_\_  
Application for plugging filed \_\_\_\_\_ 19\_\_\_\_  
Application for plugging approved \_\_\_\_\_ 19\_\_\_\_  
Plugging commenced 9-21-65 \_\_\_\_\_ 19\_\_\_\_  
Plugging completed 9-22-65 \_\_\_\_\_ 19\_\_\_\_  
Reason for abandonment of well or producing formation Depleted.

If a producing well is abandoned, date of last production \_\_\_\_\_ 19\_\_\_\_  
Was permission obtained from the Conservation Division or its agents before plugging was commenced? yes

Name of Conservation Agent who supervised plugging of this well Paul Turpin  
Producing formation \_\_\_\_\_ Depth to top \_\_\_\_\_ Bottom \_\_\_\_\_ Total Depth of Well 3800 Feet  
Show depth and thickness of all water, oil and gas formations.

OIL, GAS OR WATER RECORDS

CASING RECORD

FORMATION	CONTENT	FROM	TO	SIZE	PUT IN	PULLED OUT
				10-3/4"	220'	None
				7"	3572'	1307'

Describe in detail the manner in which the well was plugged, indicating where the mud fluid was placed and the method or methods used in introducing it into the hole. If cement or other plugs were used, state the character of same and depth placed, from \_\_\_\_\_ feet to \_\_\_\_\_ feet for each plug set.

Pipe bridged @ 435', set rock bridge to 420' and dumped 5 sacks of cement @ 420'. Pulled 7" casing, set rock bridge from 250' to 235' and dumped 20 sacks of cement @ 235'. Mudded hole to 30' and ran 10 sacks of cement to base of cellar.

RECEIVED  
STATE CORPORATION COMMISSION  
OCT 7 1965

CONSERVATION DIVISION  
Wichita, Kansas

PLUGGING COMPLETE.

(If additional description is necessary, use BACK of this sheet)

Name of Plugging Contractor KNIGHT CASING PULLING COMPANY  
Address CHASE, KANSAS

STATE OF KANSAS, COUNTY OF RICE, ss.  
Noel J. Knight (employee of owner) or (owner/representative) of the above-described well, being first duly sworn on oath, says: That I have knowledge of the facts, statements, and matters herein contained and the log of the above-described well as filed and that the same are true and correct. So help me God.

(Signature) Noel J. Knight

Chase, Kansas  
(Address)

SUBSCRIBED AND SWORN to before me this 29th day of September, 1965

Milton J. Volin  
Notary Public.

My commission expires May 20, 1968

SP

35-26-1W

Valley Center, Kansas  
February 25, 1962

15-173-01474-0000

The Drillers Production Company ✓  
212 North Market Street  
Wichita 2, Kansas

Petrie No. 3 Well

Northeast Quarter (NE/4) of the Northeast  
Quarter (NE/4) of the Northwest Quarter  
NW/4) of Section Thirty-five (35), Township  
Twenty-six (26) South, Range One (1) West,  
Sedgwick County, Kansas.

sand	-	0	-	50
shale - clay				172
anhydrite				290
shale - shells				395
lime				405
shale				499
lime				545
shale - lime				590
lime				630
lime - shale				685
lime				695
lime - shale				825
shale				890
lime - shale				900
lime				955
lime - shale				995
lime				1065
lime - shale				1110
shale - shells				1325
shale				1385
lime				1530
shale - lime				1615
shale - shells				1680
lime - shale				1725
lime				2185
lime - shale				2200
shale				2305
shale - lime				2355
lime				2380
shale				2446
lime				2470
shale				2614
K C lime top				2640
lime				3040
lime - shale				3085
shale				3112
Miss. lime				3115
chert				3123
lime				3180
lime - chert				3250
lime				3395
shale				3463
lime				3475
sand				3504
shale				3553
sand				3556
lime				3730
lime - chert				3765
lime		T.D.		3800

CASING

220 feet of 10 inch  
Surface Casing was run  
and cemented with 300  
sacks of cement.

7 inch OD 24# & 23#  
Casing was run and set  
at 3572 feet.  
Halliburton cement  
control shoe.

RECEIVED  
STATE CORPORATION COMMISSION  
OCT 7 1965  
CONSERVATION DIVISION  
Wichita, Kansas

SPRINGER & HARPER

By