


15-173-01534-0000

WELL PLUGGING RECORD

Give All Information Completely  
Make Required Affidavit  
Mail or Deliver Report to:  
Conservation Division  
State Corporation Commission  
212 North Market, Insurance Bldg.  
Wichita, Kansas

Sedgwick County, Sec. 35 Twp. 26 Rge. (E) 1W  
Location as "NE/CNW/SW" or footage from lines SE SE NW  
Lease Owner E. H. Adair Oil Co.  
Lease Name Petrie Well No. 1-B  
Office Address Wichita, Kansas  
Character of Well (completed as Oil, Gas or Dry Hole) Dry Hole  
Date well completed 2-18-61 19  
Application for plugging filed 2-18-61 19  
Application for plugging approved 2-18-61 19  
Plugging commenced 2-18-61 19  
Plugging completed 6:00 P. M. 2-18-61 19  
Reason for abandonment of well or producing formation \_\_\_\_\_

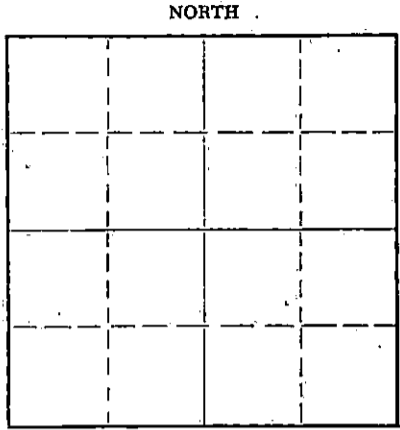

Locate well correctly on above Section Plat

If a producing well is abandoned, date of last production \_\_\_\_\_ 19  
Was permission obtained from the Conservation Division or its agents before plugging was commenced? Yes

Name of Conservation Agent who supervised plugging of this well Lee Guthrie  
Producing formation \_\_\_\_\_ Depth to top \_\_\_\_\_ Bottom \_\_\_\_\_ Total Depth of Well 3135 Feet  
Show depth and thickness of all water, oil and gas formations.

OIL, GAS OR WATER RECORDS

CASING RECORD

FORMATION	CONTENT	FROM	TO	SIZE	PUT IN	PULLED OUT
Copy of Drillers log attached hereto.						

Describe in detail the manner in which the well was plugged, indicating where the mud fluid was placed and the method or methods used in introducing it into the hole. If cement or other plugs were used, state the character of same and depth placed, from \_\_\_\_\_ feet to \_\_\_\_\_ feet for each plug set.

Mud to 180 feet. Set plug with 1/4 sack of hulls and fifteen sacks of cement. Mud to 35 feet, plug with 1/4 sack hulls and ten sacks of cement. Two sacks of cement in the rat hole.

RECEIVED  
STATE CORPORATION COMMISSION

FEB 23 1961

CONSERVATION DIVISION  
Wichita, Kansas

2-23-61

(If additional description is necessary, use BACK of this sheet)  
Name of Plugging Contractor E. H. Adair Oil Co.  
Address Wichita, Kansas

STATE OF Kansas, COUNTY OF Sedgwick, ss.  
Sherrill Compton (employee of owner) or (owner/representative) of the above-described well, being first duly sworn on oath, says: That I have knowledge of the facts, statements, and matters herein contained and the log of the above-described well as filed and that the same are true and correct. So help me God.

(Signature) Sherrill Compton  
Wichita, Kansas  
(Address)

SUBSCRIBED AND SWORN TO before me this 20th day of February, 19 61

E. Hill [Signature]  
Notary Public.

My commission expires 9-15-61

15-173-01534-0000

E. H. Adair Oil Company  
1005 East Second Street  
Wichita 14, Kansas.

E. H. Adair Oil Company,  
Petrie 1 - B,  
SE SE NW of  
Sec. 35-Twp. 26 S., Rge. 1 W.,  
Sedgwick County, Kansas.

Elevation: 1333 K.B.

Comm.: 2-12-61  
Comp.: 2-18-61  
Contractor:  
Adair - Rig No. 3  
8-5/8 in. @ 202 ft.,  
w/165 sax.  
Pro. D. & A.

Figures indicate bottoms of formations:

Line and shale to	2337	Line and shale	2872
Line	2368	Line	2987
Shale	2615	Shale and lime	3037
Lime	2782	Shale	3106
Shale	2839	Chert	3135
		T. D.	3135

Geological Tops:

LANSING	2337 ( -1004)
KANSAS CITY	2615 ( -1282)
BASE KANSAS CITY	2782 ( -1449)
MISSISSIPPI	3106 ( -1773)

Certified correct:

Sherrill Compton  
Sherrill Compton - Geologist.

RECEIVED  
STATE CORPORATION COMMISSION

FEB 23 1961

CONSERVATION DIVISION  
Wichita, Kansas