


15-173-00104-0000

STATE OF KANSAS
STATE CORPORATION COMMISSION

Give All Information Completely
Make Required Affidavit
Mail or Deliver Report to:
Conservation Division
State Corporation Commission
800 Bittling Building
Wichita, Kansas

WELL PLUGGING RECORD

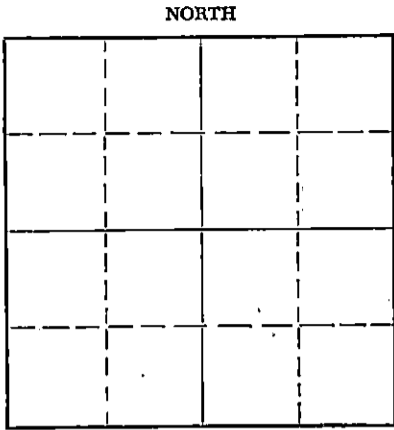

Locate well correctly on above
Section Flat

Sedgwick County. Sec. 25 Twp. 26 Rge. 1 (E) (W)
Location as "NE/CNW/SW" or footage from lines NE-NE-SW-SW
Lease Owner J. P. Gaty
Lease Name Miller Well No. 1
Office Address 11 Cypress Drive
Character of Well (completed as Oil, Gas or Dry Hole) Dry hole
Date well completed April 17 19 58
Application for plugging filed April 17 19 58
Application for plugging approved April 17 19 58
Plugging commenced 4 P. M., April 17 19 58
Plugging completed April 17 19 58
Reason for abandonment of well or producing formation Dry hole

If a producing well is abandoned, date of last production None 19
Was permission obtained from the Conservation Division or its agents before plugging was commenced? Yes

Name of Conservation Agent who supervised plugging of this well Delbert Harder
Producing formation None Depth to top Bottom Total Depth of Well 3436 Feet
Show depth and thickness of all water, oil and gas formations.

OIL, GAS OR WATER RECORDS

CASING RECORD

FORMATION	CONTENT	FROM	TO	SIZE	PUT IN	PULLED OUT
		0	190	8 5/8	190	Cemented

Describe in detail the manner in which the well was plugged, indicating where the mud fluid was placed and the method or methods used in introducing it into the hole. If cement or other plugs were used, state the character of same and depth placed, from 200 feet to 175 feet for each plug set.

Lowered suction and circulated hole with heavy mud to top
Pulled out drill pipe and bridge hole at 190' with solid bridge
Put in 20 sacks of cement. Bridged hole at 15' and put 5 sacks
cement to top. Cut off surface pipe below plow depth.

STATE CORPORATION COMMISSION
WICHITA, KANSAS
MAY 9 1958
CONSERVATION DIVISION
Wichita, Kansas

5-9-58

(If additional description is necessary, use BACK of this sheet)
Name of Plugging Contractor Glen Drilling Inc.
Address Box 547, El Dorado, Kansas.

STATE OF Kansas COUNTY OF Sedgwick, ss.
J. Arnold Dowd (employee of owner) or (owner or operator) of the above-described well, being first duly sworn on oath, says: That I have knowledge of the facts, statements, and matters herein contained and the log of the above-described well as filed and that the same are true and correct. So help me God.

(Signature) J. Arnold Dowd
(Address)

SUBSCRIBED AND SWORN TO before me this 18 day of April, 19 58

My commission expires Feb. 6, 1960

Betty Conklin
Notary Public.

24-7366-5 3-53-20M

PLUGGING
FILE SEC 25 T 26 R 14
BOOK PAGE 96 LINE 29

COMPANY

J. P. GATY
11 CYPRESS DRIVE
WICHITA, KANSAS

WELL LOG

15-173-00104-0000

LOCATION:
NE-NE-SW
SECTION 25-26-1W
SEDGWICK COUNTY, KANS.

CONTRACTOR

GLEN DRILLING, INC.
Box 547
EL DORADO, KANSAS

FARM

MILLER

DATE COMM

APRIL 7, 1958

DATE COMP

APRIL 17, 1958

TOTAL DEPTH

3436' 200' of 8 5/8" SURFACE-CEMENTED

From	To	
0	2	SURFACE SOIL
2	90	SAND & GRAVEL
90	200	SHALE & SHELLS
200	805	LIME & SHALE
805	1685	SHALE & LIME
1685	2385	LIME & SHALE
2385	2583	SHALE & LIME
2583	2612	LIME
2612	2635	CORE #1
2635	2694	LIME
2694	2705	CORE #2
2705	2736	LIME
2736	3070	LIME & SHALE
3070	3147	MISS. CHAT
3147	3310	LIME
3310	3416	SHALE & LIME
3416	3431	VIOLA LIME
3431	3436	SIMPSON DOLOMITE
	3436	TOTAL DEPTH

I HEREBY CERTIFY THAT THE FOREGOING IS A TRUE AND CORRECT COPY OF THE WELL LOG FOR THE MILLER # 1 WELL DRILLED FOR MR. J. P. GATY AND COMPLETED APRIL 17, 1958.

GLEN DRILLING, INC.
[Signature]
GLEN GAINES, PRESIDENT

STATE OF KANSAS)SS
COUNTY OF BUTLER)

SUBSCRIBED AND SWORN TO BEFORE THE UNDERSIGNED, A NOTARY PUBLIC IN AND FOR COUNTY AND STATE AFORESAID THE 18TH DAY OF APRIL 1958.

[Signature]
ALONA M. WENTWORTH, NOTARY PUBLIC.

My COMMISSON EXPIRES JUNE 21, 1961.

RECEIVED
STATE CORPORATION COMMISSION

MAY 9 1958

CONSERVATION DIVISION
Wichita, Kansas

PLUGGING
FILE SEC 25-1-26-1W
BOOK PAGE 96 LINE 29