


99

Give All Information Completely
Make Required Affidavit
Mail or Deliver Report to:
Conservation Division
State Corporation Commission
212 No. Market
Wichita, Kansas

WELL PLUGGING RECORD 15-173-30110-0000

NORTH

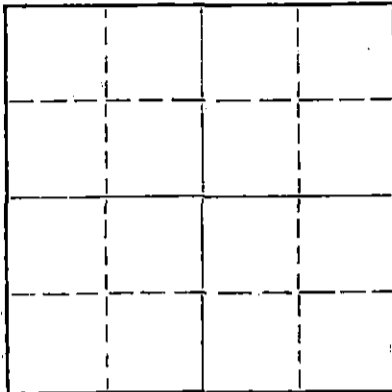

Locate well correctly on above
Section Plat

Sedgwick County, Sec. 25 Twp. 26S Rge. 1W (E) (W)
Location as "NE/CNW/SW" or footage from lines 1135' W & 2130' N of SE Corner
Lease Owner Drillers Production Co., Inc.
Lease Name Hallock Well No. 1
Office Address 480 Fourth National Bank Bldg. - Wichita, Ks.
Character of Well (completed as Oil, Gas or Dry Hole) D & A
Date well completed October 12, 1966
Application for plugging filed October 12, 1966
Application for plugging approved October 12, 1966
Plugging commenced October 12, 1966
Plugging completed October 12, 1966
Reason for abandonment of well or producing formation D & A

If a producing well is abandoned, date of last production _____ 19____
Was permission obtained from the Conservation Division or its agents before plugging was commenced? Yes

Name of Conservation Agent who supervised plugging of this well Paul Turpin
Producing formation _____ Depth to top _____ Bottom _____ Total Depth of Well 2693 Feet
Show depth and thickness of all water, oil and gas formations.

OIL, GAS OR WATER RECORDS

CASING RECORD

FORMATION	CONTENT	FROM	TO	SIZE	PUT IN	PULLED OUT
				8 5/8"	201.16'	-0-

Describe in detail the manner in which the well was plugged, indicating where the mud fluid was placed and the method or methods used in introducing it into the hole. If cement or other plugs were used, state the character of same and depth placed, from _____ feet to _____ feet for each plug set.

Mudded hole with 30 Vis. mud to 220'. Added 1/2 sx hulls. Set a dry hole plug. Added 220 sx cement. Mudded hole to 30'. Added 1/4 sx hulls. Plug & 8 sx cement. Mudded Rat Hole to 15' of surface and capped w/2 sx cement.

RECEIVED
STATE CORPORATION COMMISSION
OCT 19 1966
CONSERVATION DIVISION
Wichita, Kansas

(If additional description is necessary, use BACK of this sheet)

Name of Plugging Contractor Red Tiger Drilling Company
Address 1720 Wichita Plaza - Wichita, Ks.

STATE OF KANSAS, COUNTY OF SEDGWICK, ss.
Maxine V. Starr (employee of owner) or (~~owner~~) of the above-described well, being first duly sworn on oath, says: That I have knowledge of the facts, statements, and matters herein contained and the log of the above-described well as filed and that the same are true and correct. So help me God.

(Signature) Maxine V. Starr
1720 Wichita Plaza - Wichita, Ks.
(Address)

SUBSCRIBED AND SWORN to before me this 17th day of October, 19 66

My commission expires 5-22-70

Jean Stollar
Notary Public.

DRILLERS LOG

15-173-30110-0000

Hallock No. 1

CASING RECORD: 8 5/8" @ 201.10' w/225 sx cement

COMPANY: Drillers Production Co., Inc.

CONTRACTOR: Red Tiger Drilling Co.

COMMENCED: October 6, 1966

COMPLETED: October 12, 1966

DESCRIPTION: 1135' West and 2130' North of Southeast Corner 25-26S-1W Sedgwick Co., Kan

ELEVATION:

TOTAL DEPTH: 2693'

<u>FORMATION</u>	<u>FROM</u>	<u>TO</u>	<u>REMARKS</u>
Sand	0	55	
Shale	55	120	
Shale & Shells	120	204	
Lime & Shale	204	670	
Lime	670	865	
Shale & Shells	865	1190	
Shale & Lime	1190	2600	
Lime	2600	2693	

RECEIVED
 CORPORATION COMMISSION
 OCT 19 1966
 CONSERVATION DIVISION
 Wichita Kansas

I certify that this is a true and correct copy of the above log to the best of my knowledge.

RED TIGER DRILLING COMPANY

Maxine V. Starr
 Maxine V. Starr

Subscribed and sworn to before me this 17th day of October, 1966.

Dean Sullard
 Notary Public

My Commission Expires:

5-22-70