


WELL PLUGGING RECORD

Give All Information Completely
Make Required Affidavit
Mail or Deliver Report to:
Conservation Division
State Corporation Commission
211 No. Broadway
Wichita, Kansas

NORTH

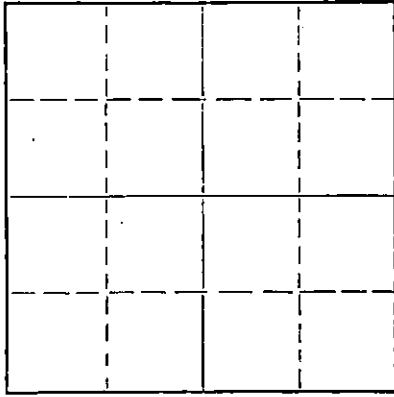

Locate well correctly on above
Section Plat

Sedgwick County, Sec. 33 Twp. 26S Rge. 1 (E) W (W)
Location as "NE/CNW/SW" or footage from lines NW NW NE
Lease Owner Frontier Oil Company
Lease Name Woodard Well No. 1
Office Address 580 Fourth Nat'l Bank Bldg. - Wichita, Kans.
Character of Well (completed as Oil, Gas or Dry Hole) D & A
Date well completed November 17 19 58
Application for plugging filed November 17 19 58
Application for plugging approved November 17 19 58
Plugging commenced November 17 19 58
Plugging completed November 17 19 58
Reason for abandonment of well or producing formation D & A

If a producing well is abandoned, date of last production _____ 19____
Was permission obtained from the Conservation Division or its agents before plugging was commenced? Yes

Name of Conservation Agent who supervised plugging of this well Ruel E. Durkee
Producing formation _____ Depth to top _____ Bottom _____ Total Depth of Well _____ Feet
Show depth and thickness of all water, oil and gas formations.

OIL, GAS OR WATER RECORDS

CASING RECORD

FORMATION	CONTENT	FROM	TO	SIZE	PUT IN	PULLED OUT
				8 5/8"	185'	-0-

Describe in detail the manner in which the well was plugged, indicating where the mud fluid was placed and the method or methods used in introducing it into the hole. If cement or other plugs were used, state the character of same and depth placed, from _____ feet to _____ feet for each plug set.

Filled hole with heavy mud. Broke down drill pipe. Set bottom plug @ 180'. Put 1/2 sack of Hulls and 20 sacks of cement on bottom plug. Set top plug @ 40'. Put 1/2 sack of Hulls and 10 sacks of cement on top plug. Filled to base of cellar.

(If additional description is necessary, use BACK of this sheet)

Name of Plugging Contractor Red Tiger Drilling Company
Address Box 173 - Russell, Kansas

STATE OF Kansas, COUNTY OF Sedgwick, ss.
George A. Angle (owner or operator) of the above-described well, being first duly sworn on oath, says: That I have knowledge of the facts, statements, and matters herein contained and the log of the above-described well as filed and that the same are true and correct. So help me God.

(Signature) George A. Angle
580 Fourth Nat'l Bank Bldg. - Wichita
(Address)

SUBSCRIBED AND SWORN TO before me this 19th day of November

My commission expires 11-17-62

PLUGGING
FILE SEC. 33 T. 26 R. 1W
BOOK PAGE 148 LINE 42

RECEIVED
STATE CORPORATION COMMISSION
Wichita
NOV 21 1958
Notary Public
Wichita

15-173-00087-0000

DRILLERS LOG

No. 1 Woodard

CASING RECORD: 8 5/8" @ 185* w/150 sx cement
 COMPANY: Frontier Oil Company
 CONTRACTOR: Red Tiger Drilling Co.
 COMMENCED: November 3, 1958
 COMPLETED: November 17, 1958
 DESCRIPTION: NW NW NE 33-26S-1W Sedgwick County, Kansas
 ELEVATION: 1333 DF 1336 RB
 TOTAL DEPTH: 3943 (-2607)

<u>FORMATION</u>	<u>FROM</u>	<u>TO</u>	<u>REMARKS</u>
Sod and Sand	0	115	
Shale	115	130	
Lime	130	185	
Lime and Shale	185	735	
Lime	735	935	
Lime and Shale	935	1860	
Shale	1860	2025	
Shale and Lime	2025	2857	
Lime	2857	3448	
Cherty Lime	3448	3551	
Lime	3551	3809	
Lime and Shale	3809	3885	
Lime	3885	3918	
Arbuckle	3918	3943	

I certify that this is a true and correct copy of the above log to the best of my knowledge.

FRONTIER OIL COMPANY

George A. Angle
George A. Angle

Subscribed and sworn to before me this 19th day of November, 1958.

Maryne Head
Notary Public

My Commission Expires:

11-17-62

PLUGGING			
FILE	SEC 33	T 26	R 1W
BOOK	PAGE 148	LINE 42	

RECEIVED
 STATE CORPORATION COMMISSION
 NOV 21 1958
 CORPORATION DIVISION