

15-173-30107-0000

CP

STATE OF KANSAS
STATE CORPORATION COMMISSION

Form CP-4

WELL PLUGGING RECORD

Give All Information Completely
Make Required Affidavit
Mail or Deliver Report to:
Conservation Division
State Corporation Commission
212 No. Market
Wichita, Kansas

Sedgwick County. Sec. 34 Twp. 26S Rge. 1 (E) 1 (W)

Location as "NE/CNW/SW" or footage from lines 6-SW/4-SW/4

Lease Owner Amerada Petroleum Corporation

Lease Name Agnes Kessler Well No. 1

Office Address Box 197, Great Bend, Kansas

Character of Well (completed as Oil, Gas or Dry Hole) Dry Hole

Date well completed 2-5- 19 66

Application for plugging filed 2-10 19 66

Application for plugging approved 2-8- 19 66


Plugging commenced 11:00 a.m. 2-5 19 66

Plugging completed 2:00 p.m. 2-5 19 66

Reason for abandonment of well or producing formation Dry

If a producing well is abandoned, date of last production - 19 -

Was permission obtained from the Conservation Division or its agents before plugging was commenced? Yes

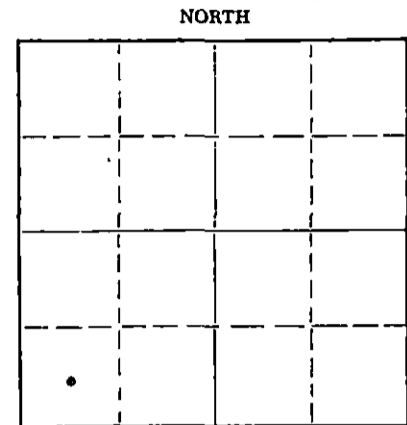

Locate well correctly on above Section Plat

Name of Conservation Agent who supervised plugging of this well Paul Turpin, Clearwater, Kansas

Producing formation _____ Depth to top _____ Bottom _____ Total Depth of Well 3970 Feet

Show depth and thickness of all water, oil and gas formations.

OIL, GAS OR WATER RECORDS

CASING RECORD

FORMATION	CONTENT	FROM	TO	SIZE	PUT IN	PULLED OUT
				8-5/8"	252'	None

Describe in detail the manner in which the well was plugged, indicating where the mud fluid was placed and the method or methods used in introducing it into the hole. If cement or other plugs were used, state the character of same and depth placed, from _____ feet to _____ feet for each plug set.

Filled hole with heavy mud from 3970' to 200'
Halliburton Spotted Cement Plug from 200' to 125' With 25 Sacks Cement and 1/2 Sack Halls
Filled hole with heavy mud from 125' to 40'
Halliburton Spotted Cement Plug from 40' to Bottom of Cellar With 10 Sacks Cement and 1/2 Sack Halls
Filled rat hole with 10 Sacks Cement - Finished at 2:00 p.m. 2-5-66

RECEIVED
STATE CORPORATION COMMISSION

FEB 14 1966

CONSERVATION DIVISION
Wichita, Kansas

(If additional description is necessary, use BACK of this sheet)

Name of Plugging Contractor Leben Drilling Inc.
Address 815 Wichita Plaza, Wichita, Kansas

STATE OF Kansas, COUNTY OF Barton, ss.
C.E. Richardson (employee of owner) or (owner or operator) of the above-described well, being first duly sworn on oath, says: That I have knowledge of the facts, statements, and matters herein contained and the log of the above-described well as filed and that the same are true and correct. So help me God.

(Signature) C.E. Richardson
C.E. Richardson Farm Boss
(Address)

SUBSCRIBED AND SWORN TO before me this 10 day of February 19 66

My commission expires November 21, 1969

Charles W. Anderson
Charles W. Anderson Notary Public.

34-26-1W

6p

DRILLER'S LOG

15-173-30107-0560

COMPANY: Amerada Petroleum Corporation
 CONTRACTOR: LEBEN DRILLING, INC.
 FARM: KESSLER #1
 LOCATION: C SW SW Sec. 34-26S-1W
 SEDGWICK COUNTY, KANSAS
 COMMENCED: 1-24-66
 COMPLETED: 2-5-66

0	50	Sand
50	195	Sand & Shale Streaks
195	260	Shale
260	470	Lime
470	1030	Lime & Shale
1030	1430	Shale
1430	1702	Shale & Lime
1702	2210	Lime & Shale
2210	2460	Shale & Lime
2460	3075	Lime & Shale
3075	3280	Shale & Lime
3280	3410	Lime & Shale
3410	3545	Lime, Shale, Chert
3545	3585	Mississippi
3585	3658	Lime & Chert
3658	3700	Mississippi
3700	3760	Lime & Shale
3760	3839	Kinderhook
3839	3844	Lime
3844	3880	Sand
3880	3921'	Sand & Shale
3921	3950	Simpson
3950	3970	Lime
	3970	<u>RTD - D & A</u>

RECEIVED
 STATE CORPORATION COMMISSION
 FEB 14 1966
 CONSERVATION DIVISION

Set 8 5/8" new surface casing @ 259.54' cemented with 250 sacks
 Common with 2% cc in last 100 sacks

I, Leslie Kite, do hereby certify that the above and foregoing is
 a true and correct copy of the log of the Kessler #1 well, located
 C SW SW of Section 34, Township 26 South, Range 1 West, Sedgwick
 County, Kansas, as reflected by the records of Leben Drilling, Inc.

Leslie Kite
 Leslie Kite

STATE OF KANSAS)
) SS
 COUNTY OF BARTON)

Subscribed and sworn to and before me, a Notary Public,
 in and for Barton County, Kansas, this 10th day of February, 1966.

Ulanda Nichols
 Ulanda Nichols

My Commission Expires:
 April 1, 1967