

WELL PLUGGING RECORD

Give All Information Completely
Make Required Affidavit
Mail or Deliver Report to:
Conservation Division
State Corporation Commission
211 No. Broadway
Wichita, Kansas

Sedgwick County. Sec. 36 Twp. 26 Rge. (E) 1 (W)

Location as "NE/CNW/SW" or footage from lines NW SW SE

Lease Owner Shawver-Armour, Inc.

Lease Name Watson Well No. 1

Office Address 817 Central Building, Wichita, Kansas

Character of Well (completed as Oil, Gas or Dry Hole) Dry hole

Date well completed 9-23 19 57

Application for plugging filed 9-23 19 57

Application for plugging approved 9-23 19 57


Plugging commenced 9-23 19 57

Plugging completed 9-23 19 57

Reason for abandonment of well or producing formation Dry hole

If a producing well is abandoned, date of last production 19

Was permission obtained from the Conservation Division or its agents before plugging was commenced? Yes

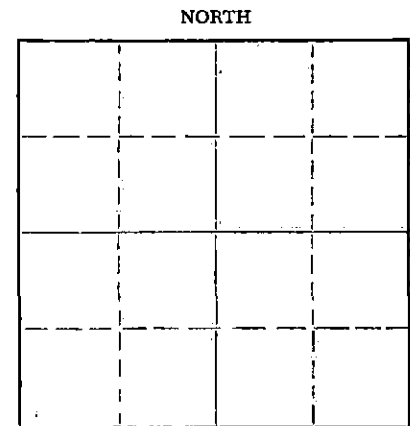

Locate well correctly on above Section Plat

Name of Conservation Agent who supervised plugging of this well Ruel Durkee

Producing formation Simpson Depth to top 3441 Bottom 3450 Total Depth of Well 3450 Feet

Show depth and thickness of all water, oil and gas formations.

OIL, GAS OR WATER RECORDS

CASING RECORD

FORMATION	CONTENT	FROM	TO	SIZE	PUT IN	PULLED OUT
Surface	Water	0		197	8 5/8	none

Describe in detail the manner in which the well was plugged, indicating where the mud fluid was placed and the method or methods used in introducing it into the hole. If cement or other plugs were used, state the character of same and depth placed, from _____ feet to _____ feet for each plug set.

Gun pits up bring heavy mud around heavy mud to 185'
#1 plug 185' Haliburton Plug and 1/2 sk Hulls
20 sks cement thru drill pipe then heavy mud to 30'
#2 plug 30' haliburton Plug and 1/2 sk hulls
10 sk cement to base of cellar

(If additional description is necessary, use BACK of this sheet)

Name of Plugging Contractor Shawver-Armour, Inc.

Address 817 Central Building, Wichita, Kansas

STATE OF KANSAS, COUNTY OF SEDGWICK, ss.

JAMES ARMOUR (employee of owner) or (owner or operator) of the above-described well, being first duly sworn on oath, says: That I have knowledge of the facts, statements, and matters herein contained and the log of the above-described well as filed and that the same are true and correct. So help me God.

(Signature) James Armour
JAMES ARMOUR
817 Central Building
(Address)

SUBSCRIBED AND SWORN TO before me this 1st day of October, 19 57

My commission expires December 29, 1959

MARJORIE WALL
Notary Public.

PLUGGING
FILE SEC. 36 T. 26 R. 1W
BOOK PAGE 49 LINE 25

RECEIVED
STATE CORPORATION COMMISSION
OCT 2 - 1957 10-2-57
CONSERVATION DIVISION

DRILLING LOG

COMPANY: SHAWVER-ARMOUR, INC.

LOCATION: NW SW SE
Section 36-26-1W
Sedgwick County

CONTRACTORS: SHAWVER-ARMOUR, INC.

FARM NAME: WATSON NO. 1

ELEVATION: 1320 GF 1325 KB

COMMENCED: 9-13-57

COMPLETED: 9-23-57

15-173-00241-0000

CASING RECORD

8 5/8 197' 170' sx. 2% cc

FORMATION

TOPS

SURFACE CLAY & SAND	50
GRAVEL & CLAY	85
SHALE	160
ANHYDRITE	265
LIME & SHALE	735
SHALE & LIME SHELLS	1205
SHALE & SHELLS	1494
SHALE & LIME SHELLS	1785
SHALE & LIME	2580
KANSAS CITY LIME	2618
LIME	2706
BASE K. C. LIME	2786
LIME & SHALE	3056
MISSISSIPPI LIME	3120
MISSISSIPPI LIME & CHERT	3220
LIME & CHERT	3255
LIME & DOLOMITE	3280
LIME & CHERT	3290
SHALE & LIME	3365
LIME & SHALE	3410
SHALE & LIME	3436
VIOLA LIME	3441
SIMPSON SAND	3450 RTD

KANSAS CITY	2580
MISSISSIPPI	3057
VIOLA	3436
SIMPSON	3441

STATE OF KANSAS)
) SS
SEDGWICK COUNTY)

I, James Armour, do hereby certify that the above is a true and correct copy of the log on the above captioned well, as shown on the daily drilling reports.

SHAWVER-ARMOUR, INC.

BY James Armour
JAMES ARMOUR

Subscribed and sworn to before me this
23 day of September 1957

My commission expires December 29, 1959

Marjorie Hall
MARJORIE HALL, NOTARY PUBLIC

PLUGGING
FILE SEC. 36 T. 26 R. 1W
BOOK PAGE 49 LINE 2S

RECEIVED
STATE CORPORATION COMMISSION
SEP 28 1957
DIVISION