


STATE OF KANSAS  
STATE CORPORATION COMMISSION

Give All Information Completely  
Make Required Affidavit  
Mail or Deliver Report to:  
Conservation Division  
State Corporation Commission  
211 No. Broadway  
Wichita, Kansas

## WELL PLUGGING RECORD

NORTH

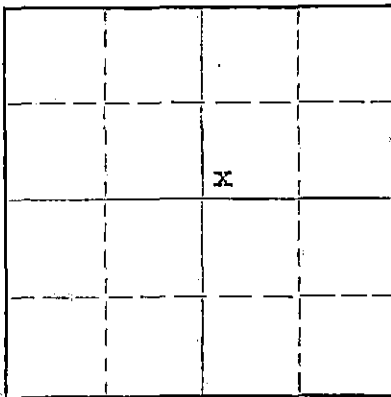

Locate well correctly on above  
Section Plat

Sedgwick County, Sec. 12 Twp. 26 Rge. 1 W (W)  
Location as "NE/CNW/SW" or footage from lines SW corner NE 1/4  
Lease Owner Cities Service Production Company  
Lease Name A. P. Wright Well No. 1  
Office Address Bartlesville, Okla.  
Character of Well (completed as Oil, Gas or Dry Hole) Oilwell  
Date well completed November 19 41  
Application for plugging filed August 28 19 56  
Application for plugging approved August 28 19 56  
Plugging commenced August 29 19 56  
Plugging completed September 6 19 56  
Reason for abandonment of well or producing formation Un-profitable to produce

If a producing well is abandoned, date of last production August 1 19 56  
Was permission obtained from the Conservation Division or its agents before plugging was commenced? Yes

Name of Conservation Agent who supervised plugging of this well Rural Durkey  
Producing formation Viola Lime & Miss. Depth to top 3339 Bottom 3349 Total Depth of Well 3349 Feet  
Show depth and thickness of all water, oil and gas formations.

## OIL, GAS OR WATER RECORDS

## CASING RECORD

FORMATION	CONTENT	FROM	TO	SIZE	PUT IN	PULLED OUT
Surface				10 3/4"	157'	0
Viola Lime & Miss.		3339	3349	5 1/2	3339'	2016'

Describe in detail the manner in which the well was plugged, indicating where the mud fluid was placed and the method or methods used in introducing it into the hole. If cement or other plugs were used, state the character of same and depth placed, from \_\_\_\_\_ feet to \_\_\_\_\_ feet for each plug set.

This well was plugged back from the T. D. of 3349' to 3195' and pumped from the Mississippi formation in March of 1947 and pumped from that formation until August 1, 1956  
The hole was filled w/ sand 3195' to 2990' six sacks cement at 2990'. Mud to 1558'.  
Ran 20 sacks cement at 155' and mudded to 10'. Ran 5 sacks cement to cap

(If additional description is necessary, use BACK of this sheet)

Name of Plugging Contractor C. E. Shull Casing pulling Co.,  
Address Box 558 Great Bend, Kansas License # 8

STATE OF Kansas, COUNTY OF Butler, ss.  
C. D. Bradbury (employee of owner) for (owner or operator) of the above-described well, being first duly sworn on oath, says: That I have knowledge of the facts, statements, and matters herein contained and the log of the above-described well as filed and that the same are true and correct. So help me God.


(Signature)

C. D. Bradbury  
Augusta, Kansas  
(Address)

SUBSCRIBED AND SWORN TO before me this 14th day of September, 19 56

My commission expires June 6, 1959

Notary Public.

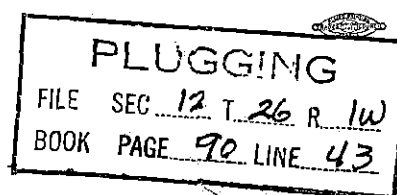

SEP 20 1956  
STATE CORPORATION COMMISSION  
Wichita, Kansas

9-20-56

## Cities Service Oil Company

Sec. 12-26S-1W  
Sedgwick Co., Kansas

#1 A. P. Wright

Drig. Comm:  
Drig. Comp: Nov. 1941Loc: SW Cor. of NE<sub>1</sub>  
Elev. 1342' D.F.

T.D. 3349'

## Casing Record:

I.P. 80 bbls. 1st 24 hrs. after  
plugging back 3/4/4710 3/4" 161' cem. 145 sax  
5 1/2" OD 3339' cem. 200 sax

## Formation Record:

## Depth:

sand and gravel	0 - 65
shale & shells	150
lime	158
shale	160
lime	161
broken lime	718
shale & shells	1655
shale & broken lime	1786
shale & shells	1888
broken lime	2260
lime	2280
broken lime & shale	2314
lime	2473
shale & shells	2511
broken lime	2564
lime	2698
broken lime & shale	2722
shale & shells	2778
lime	2821
broken lime	2859
lime	2935
shale & shells	2995
chat	2999
shale	3006
chert	3015
chat	3055
lime	3063
chert	3075
lime	3231
broken lime	3273
shale & shells	3312
sandy shale	3340
lime	3349

Plugged back to 3050'

Perforated from 3002' to 3020'.

T.D. 3349'

5-7-48  
ehRECEIVED  
STATE OF KANSAS COMMISSIONCONSERVATION DIVISION  
Topeka, Kansas

PLUGGING			
FILE	SEC 12	T 26	R 1W
BOOK	PAGE 90	LINE	43