


Required A. or Deliver Report to Conservation Division of Kansas State Corporation Commission. Information Completely Affidavit to: Commission. Broadway Wichita, Kansas

WELL PLUGGING RECORD

Sedgwick County, Sec. 12 Twp. 26S Rge. 1W (W) Location as "NE/CNW4SW4" or footage from lines NW/CN NW/ SE/ Lease Owner Cities Service Production Co., Lease Name A. C. Wright Well No. 1 Office Address Bartlesville, Okla. Character of Well (completed as Oil, Gas or Dry Hole) Oil Well Date well completed October 30 19 41 Application for plugging filed Sept. 1 19 56 Application for plugging approved Sept. 1 19 56 Plugging commenced September 8 19 56 Plugging completed September 15 19 56 Reason for abandonment of well or producing formation Unprofitable to produce

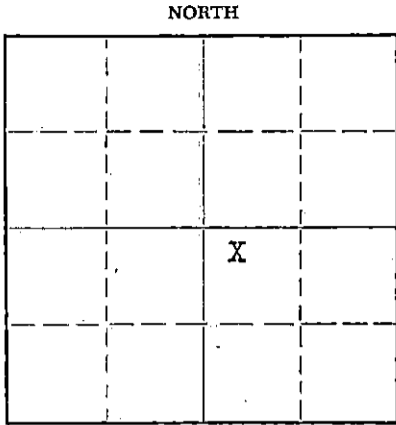

Locate well correctly on above Section Plat

If a producing well is abandoned, date of last production August 24 19 56 Was permission obtained from the Conservation Division or its agents before plugging was commenced? yes

Name of Conservation Agent who supervised plugging of this well Mr Durkee Producing formation Miss. & Viola lms. Depth to top 3336 Bottom 3338 Total Depth of Well 3338 Feet Show depth and thickness of all water, oil and gas formations.

OIL, GAS OR WATER RECORDS

CASING RECORD

Table with 7 columns: FORMATION, CONTENT, FROM, TO, SIZE, PUT IN, PULLED OUT. Rows include Surface (12 1/2" size, 162' put in) and Mississippi & Viola (7" size, 3050' put in, 1433' pulled out).

Describe in detail the manner in which the well was plugged, indicating where the mud fluid was placed and the method or methods used in introducing it into the hole. If cement or other plugs were used, state the character of same and depth placed, from feet to feet for each plug set.

Filled with sand to 2990', ran 6 sacks cement 2990', mud to 160' and bridge with rock to 150', ran 30 sacks cement from 150' and mud to 15' and capped with 8 sacks cement

RECEIVED CONSERVATION COMMISSION OCT 16 1956 10-16-56 CONSERVATION DIVISION WICHITA, KANSAS

Name of Plugging Contractor C. E. Shull Casing Pulling Co., Address Box 558, Great Bend, Kansas License # 8

STATE OF Kansas, COUNTY OF Butler, ss. G. D. Bradbury (employee of owner) of the above-described well, being first duly sworn on oath, says: That I have knowledge of the facts, statements, and matters herein contained and the log of the above-described well as filed and that the same are true and correct. So help me God.

(Signature) G. D. Bradbury Route # 2, Augusta, Kansas (Address)

SUBSCRIBED AND SWORN TO before me this 11th day of October, 19 56

My commission expires June 6, 1959

(Signature) Notary Public.

PLUGGING FILE SEC. 12 T. 26 R. 1W BOOK PAGE 91 LINE 12

Cities Service Oil Company

Sec. 12-26-S-1W
Sedgwick Co., Kansas

#1 A.C. Wright

Drlg. Comm: Oct. 15, 1941
Drlg. Comp: Oct. 30, 1941

Loc: NW $\frac{1}{4}$ NW $\frac{1}{4}$ SE $\frac{1}{4}$ 2310'N of SL & 330'E of
WL of $\frac{1}{2}$ Section.
Elev. 1341' ground

T.D. 3338'

I.P. 141 bbls. oil, 857 bbls. wtr., 1st
24 hrs. 11/18/41
I.P. 30 bbls. 1st 24 hrs. after plugging
back. 3/20/42

Casing Record:
12 $\frac{1}{2}$ " 162'1" cem. 146 sax
7" OD 3355'10" cem. 250 sax

Formation Record:

	Depth:
sand	0 - 54
shale & shells	115
hard sand	130
shale	140
lime	155
broken lime	160
lime	161
broken lime	251
lime	367
broken lime	605
lime	710
broken lime	872
shale & shells	1650
lime & shale streaks	1769
broken lime	1894
shale & shells	2135
broken lime	2377
broken lime & shale	2529
broken lime	2634
lime & shale	2685
broken lime	2737
lime	2814
broken lime	2850
shale & lime shells	2920
lime	2950
shale	2975
shale & shells	3004
chat	3075
chert	3093
lime	3238
shale	3280
shale & shells	3322
shale	3331
Dolomite shale	3336
Viola Dolomite	3338

T.D. 3338'

5-7-48
eh.

PLUGGING
FILE SEC 12 T 26 RIW
BOOK PAGE 91 LINE 12

Plugged back to 3050'
Perforated from 3004' to 3020'.

Pumped 4 $\frac{1}{2}$ bbls. fluid per hour 75% oil before
acidized. Acidized w/ 1000 gals. of acid.

RECEIVED
 STATE CORPORATION COMMISSION
 AL 215 1948
 CONSERVATION DIVISION
 Topeka, Kansas

STATE CORPORATION COMMISSION

5-7-48

CONSERVATION DIVISION
Topeka, Kansas