


Give All Information Completely
Make Required Affidavit
Mail or Deliver Report to:
Conservation Division
State Corporation Commission
211 No. Broadway
Wichita, Kansas

WELL PLUGGING RECORD 15-187-00078-0000

Stanton County. Sec. 32 Twp. 28 Rge. 40 (E) W (W)

Location as "NE/CNW/SW" or footage from lines NW SE
Lease Owner Kansas Natural Gas Inc. & Kansas Colorado Utilities Inc.
Lease Name Speck Well No. 1
Office Address Box 818 Hays, Kansas
Character of Well (completed as Oil, Gas or Dry Hole) Gas
Date well completed September 1949
Application for plugging filed September 8 1965
Application for plugging approved September 8 1965
Plugging commenced November 6 1965
Plugging completed November 6 1965
Reason for abandonment of well or producing formation Well was unable to produce gas in commercial amounts
If a producing well is abandoned, date of last production 1957
Was permission obtained from the Conservation Division or its agents before plugging was commenced? YES

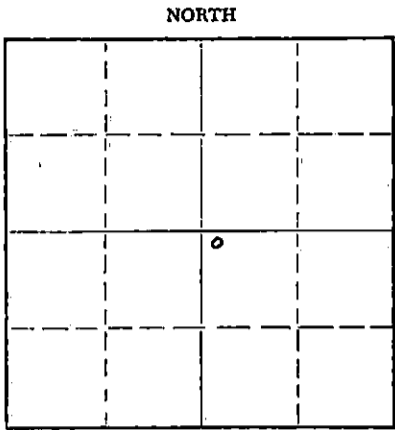

Locate well correctly on above Section Plat

Name of Conservation Agent who supervised plugging of this well Hugh Scott
Producing formation Hugoton Depth to top 2240 Bottom 2270 Total Depth of Well 2499 Feet
Show depth and thickness of all water, oil and gas formations. Plug set at 2290'

OIL, GAS OR WATER RECORDS

CASING RECORD

FORMATION	CONTENT	FROM	TO	SIZE	PUT IN	PULLED OUT
Surface	Red Beds	0	482'	10 3/4"	482'	None
Surface	T. D.	6	2500'	7"	2499'	None

Describe in detail the manner in which the well was plugged, indicating where the mud fluid was placed and the method or methods used in introducing it into the hole. If cement or other plugs were used, state the character of same and depth placed, from _____ feet to _____ feet for each plug set.

Set Plug of 20 sacks at 2000' to 2075'
Set Plug of 50 sacks at 600' to 750'
Set Plug of 30 sacks at 30' to 130'

Dug down around casing and cut off 4' below ground level,
Welded cap on casing. Backfilled hole.

RECEIVED
STATE CORPORATION COMMISSION
DEC 10 1965
CONSERVATION DIVISION
Wichita, Kansas

(If additional description is necessary, use BACK of this sheet)

Name of Plugging Contractor Sund Cementing Company
Address Liberal, Kansas

STATE OF Kansas COUNTY OF Linn, ss.
Ralph Hendle (employee of owner) or (owner or operator) of the above-described well, being first duly sworn on oath, says: That I have knowledge of the facts, statements, and matters herein contained and the log of the above-described well as filed and that the same are true and correct. So help me God.

(Signature) Ralph Hendle
Box 537 Garden City, Mo. (Address)

SUBSCRIBED AND SWORN TO before me this 7th day of December, 1965

My commission expires 3-13-66 Alan R. Peterson Notary Public.