


WELL PLUGGING RECORD

15-081-30096-0000

Give All Information Completely
Make Required Affidavit
Mail or Deliver Report to:
Conservation Division
State Corporation Commission
211 No. Broadway
Wichita, Kansas

Haskell County, Sec. 8 Twp. 28S Rge. 34W (E) (W)
Location as "NE/CNW/SW" or footage from lines C NW SE
Lease Owner W. J. Coppinger et al
Lease Name Goering Well No. 1
Office Address 1207 Union Nat'l Bldg., Wichita, Kansas
Character of Well (completed as Oil, Gas or Dry Hole) Dry Hole
Date well completed 19____
Application for plugging filed 11/18/66 19____
Application for plugging approved 11/18/66 19____
Plugging commenced 11/18/66 19____
Plugging completed 11/18/66 19____
Reason for abandonment of well or producing formation Dry

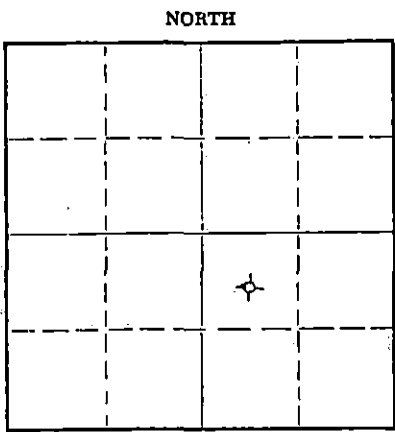

Locate well correctly on above Section Plat

If a producing well is abandoned, date of last production 19____
Was permission obtained from the Conservation Division or its agents before plugging was commenced? Yes

Name of Conservation Agent who supervised plugging of this well Edgar Eves
Producing formation _____ Depth to top _____ Bottom _____ Total Depth of Well 5640 Feet
Show depth and thickness of all water, oil and gas formations.

OIL, GAS OR WATER RECORDS

CASING RECORD

FORMATION	CONTENT	FROM	TO	SIZE	PUT IN	PULLED OUT
		0	856	8 5/8	856	0

Describe in detail the manner in which the well was plugged, indicating where the mud fluid was placed and the method or methods used in introducing it into the hole. If cement or other plugs were used, state the character of same and depth placed, from _____ feet to _____ feet for each plug set.

Set plug @700, 35 sax cement; fill with mud to 45'.
Set plug @ 45' to 3' below ground level.
By Halliburton

RECEIVED
STATE CORPORATION COMMISSION
NOV 22 1966
CONSERVATION DIVISION
Wichita, Kansas

(If additional description is necessary, use BACK of this sheet)
Name of Plugging Contractor Mahoney Drilling Company, Inc.
Address Box 1257, Liberal, Kansas

STATE OF KANSAS, COUNTY OF SEDGWICK, ss.
F. W. Mallonee one of the (Employee of owner) or (owner or operator) of the above-described well, being first duly sworn on oath, says: That I have knowledge of the facts, statements, and matters herein contained and the log of the above-described well as filed and that the same are true and correct. So help me God.

(Signature) F. W. Mallonee
F. W. Mallonee
1207 Union National Building, Wichita, Kansas
(Address)

Subscribed and Sworn to before me this 21st day of November, 1966

My commission expires April 23, 1968

Leola Lynskey
Leola Lynskey
Notary Public.

DRILLING LOG

15-081-30096-0000

LEASE OWNER Mallonee-Coppinger Operations ADDRESS Wichita, Kansas
LEASE Goering COUNTY Haskell DESCRIPTION C NW/4 SE/4
Sec. 8-28S-34W

CASING: SIZE 8-5/8" WEIGHT 20# AMOUNT 856KB.

CEMENT: AMOUNT 500 Sx. CIRCULATED: Yes X No _____

CASING: SIZE _____ WEIGHT _____ AMOUNT _____

CEMENT: AMOUNT _____ Sx. CIRCULATED: Yes _____

PLUG SET: 700 Ft. TO _____ Ft. CEMENT 35

45 Ft. TO 0 Ft. CEMENT 35

RECEIVED
STATE CORPORATION COMMISSION

NOV 28 1966

CONSERVATION DIVISION
Wichita, Kansas

FORMATION AND DEPTH

Surface Sand	0	TO	245
Water Sand	245	TO	345
Sand & Clay	345	TO	536
Shale-Red Bed	536	TO	857
Red Bed & Sand	857	TO	1600
Red Bed ; Sand	1600	TO	1910
Red Bed Shale Anhydrite	1910	TO	2497
Shale & Lime	2497	TO	4490
Lime	4490	TO	5275
Lime & Shale	5275	TO	5483
Lime	5483	TO	5640
		TO	
		TO	
		TO	

THIS IS A TRUE AND EXACT COPY OF THE FORMATIONS TAKEN FROM THE DAILY DRILLING REPORTS.

Executed this 19 day of November 19 66

By William L. Dean

IN WITNESS WHEREOF, I have hereunto set my hand and affixed my official seal the day and year above written.

George W. Carnahan Jr.
Notary Public

MY COMMISSION EXPIRES: January 24, 1968

