

STATE OF KANSAS
STATE CORPORATION COMMISSION


Form CP-4

Give All Information Completely
Make Required Affidavit
Mail or Deliver Report to:
Conservation Division
State Corporation Commission
212 No. Market
Wichita, Kansas 67202

WELL PLUGGING RECORD

Haskell County. Sec. 20 Twp. 28S Rge. 34 (E) 34 (W)

Location as "NE/CNWSW4" or footage from lines. NW SE
Lease Owner Mobil Oil Corporation
Lease Name Sprunger A Well No. 2
Office Address P. O. Box 1934, Oklahoma City, Oklahoma 73101
Character of Well (completed as Oil, Gas or Dry Hole) Oil
Date well completed May 11 1959
Application for plugging filed August 20 1973
Application for plugging approved August 22 1973
Plugging commenced October 27 1973
Plugging completed October 29 1973
Reason for abandonment of well or producing formation Uneconomical to produce.

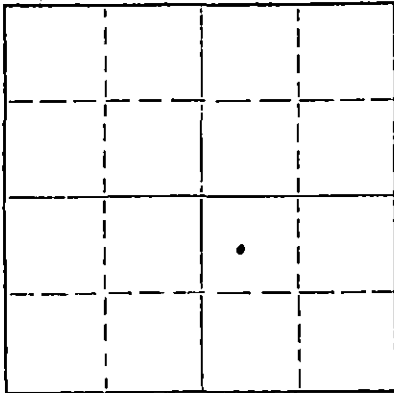

Locate well correctly on above
Section Plat

If a producing well is abandoned, date of last production _____ 19____
Was permission obtained from the Conservation Division or its agents before plugging was commenced? Yes

Name of Conservation Agent who supervised plugging of this well Mr. Edgar Eves
Producing formation Mississippian Depth to top 5373' Bottom 5489' Total Depth of Well 5550 Feet
Show depth and thickness of all water, oil and gas formations.

OIL, GAS OR WATER RECORDS

CASING RECORD

FORMATION	CONTENT	FROM	TO	SIZE	PUT IN	PULLED OUT
Mississippian-Chester	Oil w/trace of water.	5373'	5489'	8-5/8"	1909'	None
				5 1/2"	5521'	2115'

Describe in detail the manner in which the well was plugged, indicating where the mud fluid was placed and the method or methods used in introducing it into the hole. If cement or other plugs were used, state the character of same and depth placed, from _____ feet to _____ feet for each plug set.

Placed 20 sack cement plug at 5400' - top of cement at 2150'. Shot 5 1/2" casing at 2115' and recovered the 5 1/2" casing from 2115'. Placed 35 sack cement plug at 1000' - 900'. Placed 15 sack cement plug in top of 8-5/8" surface casing from 45' - 0'. Cut off 8-5/8" casing 3' below ground level and welded a steel plate across the top of the 8-5/8" casing.

RECEIVED
STATE CORPORATION COMMISSION
NOV 14 1973
CONSERVATION DIVISION
Wichita, Kansas

(If additional description is necessary, use BACK of this sheet)
Name of Plugging Contractor Sargents Casing Pulling Service.
Address 620 South Lincoln, Liberal, Kansas 67901

STATE OF Oklahoma, COUNTY OF Oklahoma, ss.
Paul K. Langenberg (employee of owner) or (owner or operator) of the above-described well, being first duly sworn on oath, says: That I have knowledge of the facts, statements, and matters herein contained and the log of the above-described well as filed and that the same are true and correct. So help me God.

(Signature) Paul K. Langenberg
Paul K. Langenberg, Office Group Supervisor
P. O. Box 1934, Oklahoma City, Oklahoma 73101
(Address)

SUBSCRIBED AND SWORN TO before me this 12th day of November, 1973

Richard M. Squibb
Notary Public.

My commission expires November 17, 1977

SPRUNGER A-2

15-081-1013-0000

NW of SE Section 20-28S-34W, Haskell Co., Kansas

Rigged up Rotary Tools 11/29/58

Ran 61 Jts. (1909.59') 8-5/8" 24#
Surface Casing. Cemented w/1000
sacks, 2% CC.


Tore down Rotary Tools 12/20/58

Ran 174 Jts (5530.86') 5-1/2" 15.5#
Casing. Set @ 5521'. Cemented w/350
sacks Posmix, 1/4# Flow Seal.

<u>FORMATION</u>	<u>FROM</u>	<u>TO</u>
Surface clay & shale	0'	40'
Sand	40	412
Sand & shells	412	800
Shale & shells	800	1006
Red bed & lime	1006	1460
Red bed & shells	1460	1875
Red bed & shale	1875	1930
Shale & shells	1930	2330
Shale & Anhydrite	2330	2442
Shale, lime & Anhydrite streaks	2442	2585
Lime & Anhydrite	2585	2700
Shale & Anhydrite	2700	2820
Lime & shale	2820	2920
Lime	2920	3124
Lime & shale	3124	3550
Lime, shale & chalk streaks	3550	3620
Lime & shale	3620	3829
Lime, shale & chalk streaks	3829	3943
Lime & shale	3943	4170
Lime	4170	4330
Lime & shale	4330	4390
Lime	4390	4570
Lime & shale	4570	4638
Lime	4638	4970
Lime & shale	4970	5050
Lime	5050	5155
Lime & shale	5155	5550 T. D.

RECEIVED
STATE CORPORATION COMMISSION
AUG 22 1963
CONSERVATION DIVISION
Wichita, Kansas

I, Don S. Packer, do hereby certify that the foregoing log is true and correct,
to the best of my knowledge and belief.

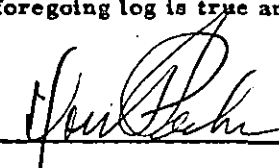

Subscribed and sworn to before me this 22nd day of December, 1958.



Notary Public

My Commission expires Nov. 26, 1962.