

STATE OF KANSAS
STATE CORPORATION COMMISSION


Form CP-4

Give All Information Completely
Make Required Affidavit
Mail or Deliver Report to:
Conservation Division
State Corporation Commission
212 No. Market
Wichita, Kansas 67202

WELL PLUGGING RECORD

Haskell County, Sec. 20 Twp. 28S Rge. (E) 34 (W)

Location as "NE/CNWKSWK" or footage from lines. C SE NE
Lease Owner Mobil Oil Corporation
Lease Name Clark "C" Well No. 1
Office Address P. O. Box 1934, Oklahoma City, Oklahoma 73101
Character of Well (completed as Oil, Gas or Dry Hole) Oil
Date well completed April 15 19 59
Application for plugging filed August 20 19 73
Application for plugging approved August 22 19 73
Plugging commenced October 30 19 73
Plugging completed November 1 19 73
Reason for abandonment of well or producing formation Uneconomical to produce.

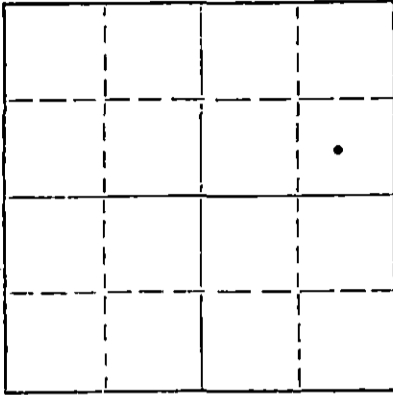

Locate well correctly on above Section Plat

If a producing well is abandoned, date of last production 19
Was permission obtained from the Conservation Division or its agents before plugging was commenced? Yes

Name of Conservation Agent who supervised plugging of this well Mr. Edgar Eves
Producing formation Morrow Depth to top 5324' Bottom 5344' Total Depth of Well 5652 Feet
Show depth and thickness of all water, oil and gas formations.

OIL, GAS OR WATER RECORDS

CASING RECORD

FORMATION	CONTENT	FROM	TO	SIZE	PUT IN	PULLED OUT
Morrow	Oil	5324'	5344'	8-5/8"	1886'	None
				5 1/2"	5562'	2204'

Describe in detail the manner in which the well was plugged, indicating where the mud fluid was placed and the method or methods used in introducing it into the hole. If cement or other plugs were used, state the character of same and depth placed, from feet to feet for each plug set.
Placed 20 sack cement plug at 5335', shot 5 1/2" casing at 2266', could not pull casing. Shot 5 1/2" casing at 2238', could not pull casing. Shot casing at 2204' and casing was free. Placed 35 sack cement plug at 1900'. Placed 15 sack cement plug in top of 8-5/8" surface casing from 45' to 0'. Cut off the 8-5/8" surface casing 3' below ground level and welded a steel plate across the top of the 8-5/8" surface casing.

RECEIVED
STATE CORPORATION COMMISSION
NOV 14 1973
CONSERVATION DIVISION
Wichita, Kansas

(If additional description is necessary, use BACK of this sheet)
Name of Plugging Contractor Sargents Casing Pulling Service
Address 620 South Lincoln, Liberal, Kansas 67901

STATE OF Oklahoma, COUNTY OF Oklahoma, ss.
Paul K. Langenberg (employee of owner) or (owner or operator) of the above-described well, being first duly sworn on oath, says: That I have knowledge of the facts, statements, and matters herein contained and the log of the above-described well as filed and that the same are true and correct. So help me God.

(Signature) Paul K. Langenberg, Office Group Supervisor
P. O. Box 1934, Oklahoma City, Oklahoma 73101
(Address)

SUBSCRIBED AND SWORN to before me this 12th day of November, 19 73

Richard M. Squibb
Notary Public.

My commission expires November 17, 1977

FORM 882

KELLEY BUSHING

3043

DERRICK FLOOR

3041

GROUND

3031

SURFACE ELEVATIONS

WELL COMPLETION REPORT

NEW WELL X

15-081-00027-0000

RECOMPLETION

REPAIR

FORMATION	DEPTH.	ELEVATION	THICK	OPERATOR:
Herington	2556	+487		N.N.G.P. Co.
Winfield	2644	+399		FARM: Clark "C"
Council Grove	2897	+146		WELL NO.: 1
Pennsylvanian	3278	-235		LOCATION: C SE NE
Heebner	3998	-955		Sec. 20-28S-34W
Toronto	4017	-974		
Lansing - Kansas City	4097	-1054		
Marmaton	4696	-1653		
Cherokee	4849	-1806		
Morrow	5171	-2128		CO.-PA. Haskell
Morrow Sandstone	5324	-2281	26'	STATE-POV. Kansas
Mississippi - Chester	5360	-2317		AREA: Hickok
Chester Sandstone	5427	-2384	14'	FIELD: Eubank
Oolitic Limestone	5472	-2429	27'	DATE COMMENCED: February 17, '59
Ste. Genevieve	5499	-2456		DATE COMPLETED: April 23, 1959
St. Louis	5584	-2541		INITIAL PRODUCTION 145 BOPD
				Morrow Sand

CASING:

ACIDIZING AND FRACTURING: (See Completion Procedure)

DIAMETER	LENGTH	WEIGHT	GRADE
8 5/8	1886		
5 1/2	5562		

TIUBING:

DIAMETER	LENGTH	WEIGHT	GRADE

PERFORATIONS:

(See Completion Procedure)

RECEIVED
STATE CORPORATION COMMISSION

AUG 22 1973

CONSERVATION DIVISION
Wichita, Kansas