

WELL PLUGGING RECORD 15-081-10108 0500

Give All Information Completely  
Make Required Affidavit  
Mail or Deliver Report to:  
Conservation Division  
State Corporation Commission  
211 No. Broadway  
Wichita, Kansas

Haskell

County. Sec. 20 Twp. 28S Rge. 34W (E) (W)

Location as "NE/CNW/SW" or footage from lines C-NW-NE

Lease Owner Mobil Oil Corporation

Lease Name Clark Well No. C-2

Office Address Box 1934, Oklahoma City, Oklahoma 73101

Character of Well (completed as Oil, Gas or Dry Hole) Gas

Date well completed 11-19 19 59

Application for plugging filed 10-16 19 69

Application for plugging approved 10-17 19 69


Plugging commenced 11-3 19 69

Plugging completed 5:30 PM 11-5 19 69

Reason for abandonment of well or producing formation depleted Gas Reservoir.

If a producing well is abandoned, date of last production April 18, 19 69

Was permission obtained from the Conservation Division or its agents before plugging was commenced? Yes

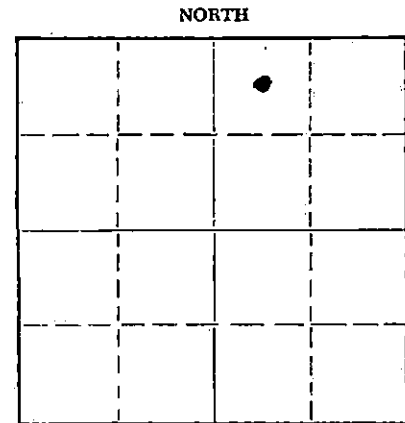

Locate well correctly on above Section Plat

Name of Conservation Agent who supervised plugging of this well Edgar J. Eves

Producing formation Lansing Depth to top 4522 Bottom 4600 Total Depth of Well 5432 Feet

Show depth and thickness of all water, oil and gas formations.

OIL, GAS OR WATER RECORDS

CASING RECORD

FORMATION	CONTENT	FROM	TO	SIZE	PUT IN	PULLED OUT
Lansing	Gas	0	1898	8 5/8"	1898	Left
		0	5432	5 1/2"	2216	3216
RECEIVED STATE CORPORATION COMMISSION NOV 17 1969 CONSERVATION DIVISION Wichita, Kansas						

Describe in detail the manner in which the well was plugged, indicating where the mud fluid was placed and the method or methods used in introducing it into the hole. If cement or other plugs were used, state the character of same and depth placed, from \_\_\_\_\_ feet to \_\_\_\_\_ feet for each plug set.

8 5/8 to 1898' circulated with cement - 5 1/2 to 5432 cemented. D. V. at 2965 cemented with 125 sacks cement. Top of cement 2318'. Top perforations 4522 - Plug Bottom with 20 sacks cement. Top of cement 4400'. -- Mud 4400' to 900'. Spotted 35 Sacks cement 900' to 800'. Mud 800' to 45' plug, Halls and 15 sacks cement 45' to 0'. Pulled 2216' of 5 1/2" casing.

Name of Plugging Contractor Sargents Casing Pulling Company (If additional description is necessary, use BACK of this sheet)

Address Box 506 Liberal, Kansas

STATE OF Oklahoma, COUNTY OF Oklahoma, ss.

Paul K. Langenberg (employee of owner) or (owner or operator) of the above-described well, being first duly sworn on oath, says: That I have knowledge of the facts, statements, and matters herein contained and the log of the above-described well as filed and that the same are true and correct. So help me God.

(Signature) Paul K. Langenberg  
P. O. Box 1934, Oklahoma City, Oklahoma 73101  
(Address)

SUBSCRIBED AND SWORN to before me this 14th day of November, 19 69

My commission expires 9-8-71

Murline Sanders  
Notary Public.

15-081-10108-0000

FORM 863

SURFACE ELEVATIONS

KELLEY BUSHING

3043

DERRICK FLOOR

3041

GROUND

3033

WELL COMPLETION REPORT

NEW WELL X

RECOMPLETION

REPAIR

FORMATION	DEPTH.	ELEVATION	THICK	OPERATOR: NNGP Co.
Herington	2568	+475		FARM: Clark "C"
Upper Krider	2590	+453		WELL NO.: 2
Lower Krider	2616	+427		LOCATION: Sec. 20-28S-34W
Winfield	2656	+387		C NW NE
Upper Fort Riley	2718	+325		
Lower Fort Riley	2768	+275		
Florence	2822	+221		
Wreford	2858	+185		
Council Grove	2908	+135		
Penn	3286	-243		CO. # Haskell County
Heebner	4006	-963		STATE # Kansas
Toronto	4026	-983		AREA: NE Hickock
Lan - KC	4104	-1061		FIELD: Eubank
Lan "A"	4154	-1111		DATE COMMENCED: 9-3-59
Lan "A-1"	4266	-1223		DATE COMPLETED: 2-8-60
Lan "B"	4340	-1297		INITIAL PRODUCTION
Lan "C"	4434	-1391		Pump 13.60 BO/24 hrs.
Lan "D"	4520	-1477		& no water
Lan "E"	4596	-1553		
Marmaton	4718	-1675		
Cherokee	4867	-1824		
Morrow	5214	-2171		
Chester	5394	-2351		
St. Gen	5536	-2493		
St. Louis	5628	-2585		

CASING:

ACIDIZING AND FRACTURING:

DIAMETER	LENGTH	WEIGHT	GRADE	
8 5/8"	1898			A/250-CUA
5 1/2"	5432			133 bbls Diesel Fuel
				Frac 180 bbls Diesel Fuel (spearhead)
				240 bbls Gel Diesel Fuel
				10,000# sd
				180 bbls Diesel Fuel (Flush)

TUBING:

Block - Buster 3,000 Gals.

DIAMETER	LENGTH	WEIGHT	GRADE	
?	5377			Block - Buster 1,000 Gals.
				A/1,000 - 15% CUA

PERFORATIONS:

Perfs 8/5371-73
8/5378-80

RECEIVED  
STATE CORPORATION COMMISSION  
OCT 17 1969  
CONSERVATION DIVISION  
Wichita, Kansas