

STATE OF KANSAS
STATE CORPORATION COMMISSION


WELL PLUGGING RECORD

15-081-10062-0000

Give All Information Completely
Make Required Affidavit
Mail or Deliver Report to
Conservation Division
State Corporation Comm.
245 North Water
Wichita, KS 67202

Haskell County, Sec. 23 Twp. 28N Rge. 34 E/W
Location as "NE/CNW $\frac{1}{4}$ SW $\frac{1}{4}$ " or footage from lines _____
C N $\frac{1}{2}$ SW $\frac{1}{4}$

Lease Owner Graham - Michaelis
Lease Name Eubank Well No. 1-23
Office Address Box 769 Woodward, Oklahoma 73801
Character of Well (Completed as Oil, Gas or Dry Hole) _____

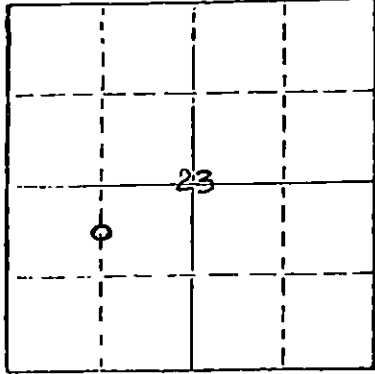

Locate well correctly on above
Section Plat

Oil Well
Date Well completed April 7, 1960
Application for plugging filed Dec. 1, 1977
Application for plugging approved Dec. 2, 1977
Plugging commenced 12-16 1977
Plugging completed 12-19 1977
Reason for abandonment of well or producing formation _____

Non-commercial
If a producing well is abandoned, date of last production
October 1977
Was permission obtained from the Conservation Division or
its agents before plugging was commenced? Yes

Name of Conservation Agent who supervised plugging of this well Clarence Thomas
Producing formation Miss. Chester Depth to top 5404 Bottom 5430 Total Depth of Well 5650'
Show depth and thickness of all water, oil and gas formations.

OIL, GAS OR WATER RECORDS

CASING RECORD

FORMATION	CONTENT	FROM	TO	SIZE	PUT IN	PULLED OUT
				8 5/8	847	none
				5 1/2	5648	1408

Describe in detail the manner in which the well was plugged, indicating where the mud fluid was placed and the method or methods used in introducing it into the hold. If cement or other plugs were used, state the character of same and depth placed, from _____ feet to _____ feet for each plug set.

Pump 2 sks. of hulls & 20 sks. of cement @ 5200 ft.
Pump 50 sks. of cement @ 847 to 747
Put 10 sks. of cement @ 40 to 0

RECEIVED
STATE CORPORATION COMMISSION

JAN 17 1978

JAN 13 1978

CONSERVATION DIVISION
Wichita, Kansas

(If additional description is necessary, use BACK of this sheet)

Name of Plugging Contractor Sargents Casing Pulling Ser. Box 506 Liberal, Kansas 67901 No. 511

STATE OF Kansas COUNTY OF Sedgwick, ss.
Jack L. Yinger (employee of owner) or (owner or operator)
of the above-described well, being first duly sworn on oath, says: That I have knowledge of the facts, statements, and matters herein contained and the log of the above-described well as filed and that the same are true and correct. So help me God.

(Signature) Jack L. Yinger

(Address)

SUBSCRIBED AND SWORN TO before me this 16th day of January, 1978

Muriel F. C. Jeram
Notary Public.

My commission expires _____

MURIEL F. C. JERAM
NOTARY PUBLIC
SEDGWICK COUNTY, KANSAS
MY COMMISSION EXPIRES
JULY 25, 1980

EUBANK #1-23

15-081-10062-0000

WELL RECORD:

LOCATION:

CN/2 SW Sec. 23-28S-34W
Haskell County, Kansas

Commenced: 2/22/60
Completed: 3/16/60
(Rotary)

CONTRACTOR:

Graham-Michaelis Drilling Co.
211 North Broadway
Wichita 2, Kansas

CASING RECORD:

27 Jts 8 5/8" 24# 8Rd Csg.
Cement w/450 sx common 2%
gel 2% cc.

178 Jts 5 1/2" 15.5# 8RT Csg
cement w/200sx common &
w/200 sx Posmix 6% gel

LOG

Clay, Sand & Shale	0 - 188
Sand & Shale	188 - 500
Red Bed, Sand & Shale	500 - 1275
Red Bed, Sand, Shale & Shells	1275 - 1772
Shale & Lime	1772 - 3308
Lime	3308 - 3478
Shale & Lime	3478 - 4532
Lime	4532 - 4607
Shale & Lime	4607 - 5329
Lime	5329 - 5385
Shale & Lime	5385 - 5491
Lime	5491 - 5650

RECEIVED
STATE CORPORATION COMMISSION

DEC 02 1977

CONSERVATION DIVISION
Wichita, Kansas

5650' - Total Rotary Depth

The undersigned, Graham-Michaelis Drilling Company, hereby certifies that the above log is a true and correct log of the formations encountered in drilling the above well as reflected by the Daily Drilling Report.

GRAHAM-MICHAELIS DRILLING COMPANY

By George Barge
Geologist