


WELL PLUGGING RECORD 15-081-10067-0000

Give All Information Completely  
Make Required Affidavit  
Mail or Deliver Report to:  
Conservation Division  
State Corporation Commission  
211 No. Broadway  
Wichita, Kansas

Haskell County, Sec. 23 Twp. 28s Rge. 34w (E) (W)  
Location as "NE/CNWxSWx" or footage from lines C-NW-NE  
Lease Owner Graham-Michaelis Drilling Co.  
Lease Name Hubank B Well No. I-23  
Office Address Box 1294 Liberal, Kansas  
Character of Well (completed as Oil, Gas or Dry Hole) Oil  
Date well completed \_\_\_\_\_ 19\_\_\_\_  
Application for plugging filed 4-21 19 64  
Application for plugging approved 4-22 19 64  
Plugging commenced 4-22 19 64  
Plugging completed 4-23 19 64  
Reason for abandonment of well or producing formation Non-commercial

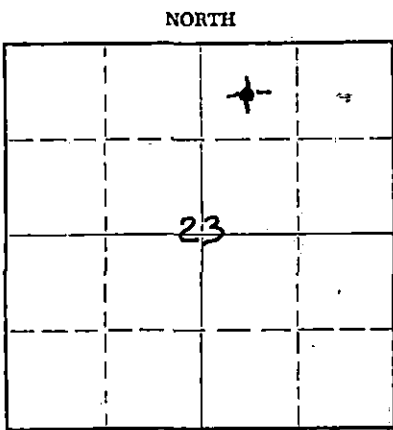

Locate well correctly on above Section Plat

If a producing well is abandoned, date of last production April 9, 1964  
Was permission obtained from the Conservation Division or its agents before plugging was commenced? Yes

Name of Conservation Agent who supervised plugging of this well High Scott  
Producing formation Morrow Sand Depth to top 5343' Bottom 5374' Total Depth of Well 5606 Feet  
Show depth and thickness of all water, oil and gas formations.

OIL, GAS OR WATER RECORDS

CASING RECORD

FORMATION	CONTENT	FROM	TO	SIZE	PUT IN	PULLED OUT
				8 5/8	783	none
				4 1/2	5450	1401

Describe in detail the manner in which the well was plugged, indicating where the mud fluid was placed and the method or methods used in introducing it into the hole. If cement or other plugs were used, state the character of same and depth placed, from \_\_\_\_\_ feet to \_\_\_\_\_ feet for each plug set.

Mix 29 sks cement to plug off perforations, stop plug at 5150. Mud to 700' and pump 35 sacks of cement at 700' to 600'. Mud to 45' and 15 sacks cement 45' to 0'. Clean cellar out to 3' below ground level and cut off and weld metal cap on 8 5/8 casing.

RECEIVED  
STATE CORPORATION COMMISSION

MAY 1 1964

APR 29 1964

CONSERVATION DIVISION  
Wichita, Kansas

(If additional description is necessary, use BACK of this sheet)  
Name of Plugging Contractor Sargent's Casing Pulling Service  
Address Box 506 Liberal, Kansas

STATE OF Kansas, COUNTY OF Sedgwick, ss.

John L. James (employee of owner) or (owner-or-operator) of the above-described well, being first duly sworn on oath, says: That I have knowledge of the facts, statements, and matters herein contained and the log of the above-described well as filed and that the same are true and correct. So help me God.

(Signature) John L. James  
John L. James Geologist  
211 North Broadway, Wichita, Kansas 67202  
(Address)

SUBSCRIBED AND SWORN TO before me this 30th day of April, 19 64

Evelyn D. Evans  
Evelyn D. Evans Notary Public.

My commission expires December 12, 1966

## WELL RECORD:

## LOCATION:

C NW/4 NE/4 Section 23-28S-34W  
Haskell County, Kansas

Commenced: 4/26/61  
Completed: 5/13/61  
(Rotary)

## CONTRACTOR:

Graham-Michaelis Drilling Co.  
Liberal Division  
P. O. Box 896  
Liberal, Kansas

## CASING RECORD:

25 Jts. 8 5/8" 21# Casing  
Cemented w/300 sx Lite Weight  
2% cc and 150 sx Common 2% cc

	LOG	
Sand	0 -	450
Shale	450 -	619
Shale & Red Bed	619 -	783
Red Bed	783 -	825
Red Bed & Gyp	825 -	2125
Red Bed, Shale & Shells	2125 -	2375
Shale & Lime	2375 -	3682
Lime	3682 -	3855
Lime & Shale	3855 -	4100
Lime	4100 -	4183
Lime & Shale	4183 -	4337
Lime	4337 -	4412
Lime & Shale	4412 -	4589
Lime	4589 -	4677
Lime & Shale	4677 -	5257
Shale, Lime & Sand	5257 -	5370
Lime & Shale	5370 -	5398
Lime & Sand	5398 -	5430
Lime	5430 -	5459
Lime & Shale	5459 -	5559
Lime	5559 -	5606

RECEIVED  
STATE CORPORATION COMMISSION

MAY 1 1964

CONSERVATION DIVISION  
Wichita, Kansas

5606' - Total Rotary Depth

The undersigned, Graham-Michaelis Drilling Company, Liberal Division, certifies that the above log is a true and correct copy of the formations encountered in drilling the above mentioned well, as taken from the Daily Drilling Report.

GRAHAM-MICHAELIS DRILLING COMPANY  
LIBERAL DIVISION

By H. R. Michaelis  
H. R. Michaelis