


WELL PLUGGING RECORD

Give All Information Completely  
Make Required Affidavit  
Mail or Deliver Report to:  
Conservation Division  
State Corporation Commission  
211 No. Broadway  
Wichita, Kansas

Haskell County, Sec. 23 Twp. 28 Rge. 34 ~~EX~~ (W)  
Location as "NE/CNW%SW%" or footage from lines NW/4 SE/4  
Lease Owner D & M Drilling Company, Inc.  
Lease Name Eubank Well No. 1  
Office Address 809 Union Center, Wichita, Kansas  
Character of Well (completed as Oil, Gas or Dry Hole) Dry Hole  
Date well completed 3/16 19 60  
Application for plugging filed 3/16 19 60  
Application for plugging approved 3/16 19 60  
Plugging commenced 3/16 19 60  
Plugging completed 3 P.M. 3/16 19 60  
Reason for abandonment of well or producing formation Dry Hole

NORTH

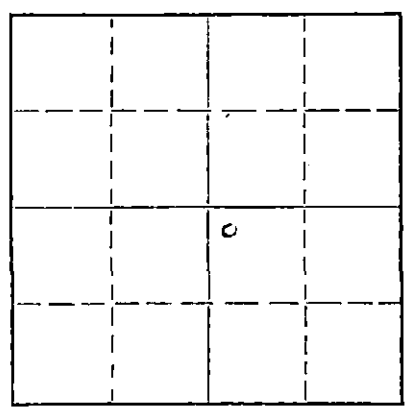

Locate well correctly on above  
Section Plat

If a producing well is abandoned, date of last production 19  
Was permission obtained from the Conservation Division or its agents before plugging was commenced? Yes

Name of Conservation Agent who supervised plugging of this well Frank Broadfoot  
Producing formation \_\_\_\_\_ Depth to top \_\_\_\_\_ Bottom \_\_\_\_\_ Total Depth of Well 5480 Feet  
Show depth and thickness of all water, oil and gas formations.

OIL, GAS OR WATER RECORDS

CASING RECORD

FORMATION	CONTENT	FROM	TO	SIZE	PUT IN	PULLED OUT
				8 5/8	813'	0

Describe in detail the manner in which the well was plugged, indicating where the mud fluid was placed and the method or methods used in introducing it into the hole. If cement or other plugs were used, state the character of same and depth placed, from \_\_\_\_\_ feet to \_\_\_\_\_ feet for each plug set.

Filled hole from total depth to 2800' with heavy mud. Set plug @2800' and pumped 100 sacks Common Cement from 2800' to 2600'. Filled with heavy mud to 800'. Set plug and cemented with 25 sacks Common cement. Filled with mud to 40'. Set plug and cemented with 15 sacks Common Cement.

RECEIVED  
STATE CORPORATION COMMISSION  
3-22-60 MAR 22 '60  
CONSERVATION DIVISION  
Wichita, Kansas

(If additional description is necessary, use BACK of this sheet)

Name of Plugging Contractor D & M Drilling Company, Inc.  
Address 809 Union Center, Wichita, Kansas

STATE OF KANSAS, COUNTY OF SEDGWICK, ss.  
I, Don S. Packer, (employee of owner) or (owner or operator) of the above-described well, being first duly sworn on oath, says: That I have knowledge of the facts, statements, and matters herein contained and the log of the above-described well as filed and that the same are true and correct. So help me God.

(Signature) *[Signature]*  
809 Union Center, Wichita, Kansas  
(Address)

SUBSCRIBED AND SWORN TO before me this 21st day of March, 19 60

My commission expires November, 3, 1963

*[Signature]*  
Dorothy M. Leslie  
Notary Public.



EUBANK # 1  
C-NW/4 SE/4 23-28S-34W  
Haskell County, Kansas

15-081-10059-0000

Rigged up Rotary Tools 2-13-60

Ran 25 Jts. 8 5/8 New 24# Casing  
(811.98) Set @ 813. Cemented  
w/550 Sacks Com. 2% c. c.

Tore Down Rotary Tools 3-16-60

<u>FORMATION</u>	<u>FROM</u>	<u>TO</u>
Sand and Shale	0'	585
Shale & Shells	585	813
Shale, Shells & Redbed	813	1213
Shale & Redbed	1213	1350
Sand	1350	1600
Shale & Lime	1600	2355
Lime	2355	2459
Lime & Shale	2459	2652
Lime	2652	2915
Lime & Shale	2915	3031
Lime	3031	3520
Lime & Shale	3520	3600
Lime	3600	3780
Chalky Lime & Shale	3780	3950
Lime Chalk	3950	4030
Lime, Shale & Chalky Streaks	4030	4140
Lime	4140	5229
Lime & Shale	5229	5380
Sand, Shale & Lime	5380	5420
Sand & Lime	5420	5480 T. D.

RECEIVED  
STATE CORPORATION COMMISSION

MAR 22 1960


CONSERVATION DIVISION  
Wichita, Kansas

STATE OF KANSAS

COUNTY OF SEDGWICK

I, Don S. Packer, do hereby certify that the foregoing is true and correct, to  
the best of my knowledge and belief.

Subscribed and sworn to before me this 16th day of March, 1960

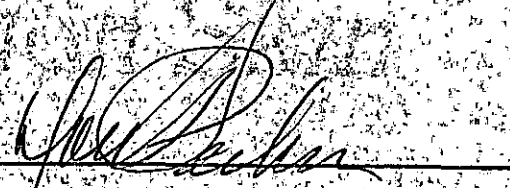  
Dorothy M. Leslie, Notary Public

My commission expires November 3, 1963