


WELL PLUGGING RECORD

Give All Information Completely  
Make Required Affidavit  
Mail or Deliver Report to:  
Conservation Division  
State Corporation Commission  
800 Biting Building  
Wichita, Kansas

Haskell County, Sec. 23 Twp. 28S Rge. (E) 34 (W)  
Location as "NE/CNW/SW" or footage from lines C NW/4 NW/4  
Lease Owner W. C. McBride, Inc. et al  
Lease Name Eubank "D" Well No. 1  
Office Address 805 Mayo Building, Tulsa, Oklahoma  
Character of Well (completed as Oil, Gas or Dry Hole) Dry Hole  
Date well completed December 20 19 59  
Application for plugging filed December 20 19 59  
Application for plugging approved December 20 19 59  
Plugging commenced December 20 19 59  
Plugging completed December 20 19 59  
Reason for abandonment of well or producing formation Dry

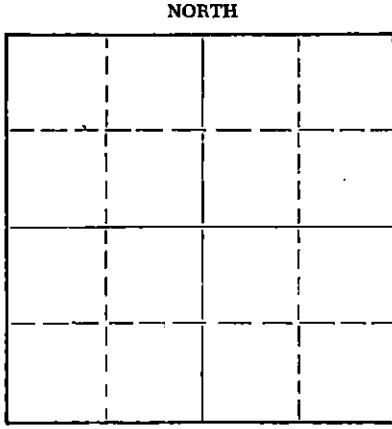

Locate well correctly on above Section Plat

If a producing well is abandoned, date of last production \_\_\_\_\_ 19\_\_\_\_  
Was permission obtained from the Conservation Division or its agents before plugging was commenced? Yes

Name of Conservation Agent who supervised plugging of this well Frank Broadfoot  
Producing formation \_\_\_\_\_ Depth to top \_\_\_\_\_ Bottom \_\_\_\_\_ Total Depth of Well 5715 Feet  
Show depth and thickness of all water, oil and gas formations.

OIL, GAS OR WATER RECORDS

CASING RECORD

FORMATION	CONTENT	FROM	TO	SIZE	PUT IN	PULLED OUT

Describe in detail the manner in which the well was plugged, indicating where the mud fluid was placed and the method or methods used in introducing it into the hole. If cement or other plugs were used, state the character of same and depth placed, from \_\_\_\_\_ feet to \_\_\_\_\_ feet for each plug set.

Cement with Halliburton @ 2850 ft. with 115 sx of bulk cement thru drill pipe.  
Cement at 600 ft. with 25 sx Halliburton cement. Cement from bottom of cellar to 30 ft. down with 10 sx Halliburton cement.

STATE OF KANSAS  
RECEIVED  
COMMISSION  
12-24-59 DEC 24 1959  
CONSERVATION DIVISION  
Wichita, Kansas

(If additional description is necessary, use BACK of this sheet)  
Name of Plugging Contractor Braden Drilling, Inc.  
Address 1206 Union National Building, Wichita, Kansas

STATE OF Kansas COUNTY OF Sedgwick, ss.  
F. M. Callaway (employee of owner) or (owner or operator) of the above-described well, being first duly sworn on oath, says: That I have knowledge of the facts, statements, and matters herein contained and the log of the above-described well as filed and that the same are true and correct. So help me God.

(Signature) [Signature]  
1206 Union National Building, Wichita, Kansas  
(Address)

SUBSCRIBED AND SWORN TO before me this 22 day of December, 19 59

My commission expires March 21, 1962  
[Signature] Notary Public.



**BRADEN DRILLING COMPANY  
DAILY DRILLING REPORT**

15-081-10104-0000

Date **12-20-59**

COMPANY <b>W. C. Mc Bride</b>		WELL NO. <b>1-D</b>	LEASE <b>G. - Eubanks</b>	RIG NO. <b>1</b>
SECTION <b>23</b>	TWP. <b>28</b>	RANGE <b>34</b>	COUNTY <b>Haskell</b>	STATE <b>Kans.</b>

TOUR NO.	FROM	TO	FORMATION	EMPLOYEE	Occupation	HOURS	MUD USED	SKS.
<b>1</b>	<b>5:15</b>	<b>TD</b>	<b>Logging</b>	<b>Jed A. Turner</b>	<b>DRLR.</b>	<b>8</b>		
HRS. RUN				<b>Walter Maier</b>	<b>DKM.</b>	<b>8</b>		
HRS. LOST				<b>Rex Flanagan</b>	<b>HLP.</b>	<b>8</b>		
				<b>John Maynard</b>	<b>HLP.</b>	<b>8</b>		
BIT TYPE	SET NO.	HRS. RUN	FOOTAGE ON BIT	CONE NO.				
BIT TYPE	SET NO.	HRS. RUN	FOOTAGE ON BIT	CONE NO.	CORE HEAD NO.	DEFLECTION:		

TIME		REMARKS	COMPANY TIME	
FROM	TO		W PIPE	WO PIPE
<b>12:00</b>	<b>2:00</b>	<b>Logging</b>		<b>2</b>
<b>2:00</b>	<b>8:00</b>	<b>Waiting on orders</b>		<b>6</b>
<p><b>RECEIVED</b> STATE COMMISSION</p> <p><b>JAN 5 1960</b></p> <p><b>CONSERVATION DIVISION</b> <b>Wichita, Kansas</b></p>				

TOUR NO.	FROM	TO	FORMATION	EMPLOYEE	Occupation	HOURS	MUD USED	SKS.
<b>2</b>				<b>Joe E. Mc Coy</b>	<b>DRLR.</b>			
HRS. RUN				<b>Larry J. ...</b>	<b>DKM.</b>			
HRS. LOST				<b>Geo. ...</b>	<b>HLP.</b>			
				<b>Harry ...</b>	<b>HLP.</b>			
BIT TYPE	SET NO.	HRS. RUN	FOOTAGE ON BIT	CONE NO.				
BIT TYPE	SET NO.	HRS. RUN	FOOTAGE ON BIT	CONE NO.	CORE HEAD NO.	DEFLECTION:		

TIME		REMARKS	COMPANY TIME	
FROM	TO		W PIPE	WO PIPE
<b>8:00</b>	<b>9:00</b>	<b>Wait on Orders</b>		<b>1</b>
<b>9:00</b>	<b>1:30</b>	<b>Run D.P. in hole &amp; lay down D.P.</b>		
<b>1:30</b>	<b>2:00</b>	<b>Cemented with Halliburton @ 2850 with 115 SX of Bulk Cement thru D.P.</b>	<b>1/2</b>	
<b>2:00</b>	<b>3:00</b>	<b>Lay down D.P. from 2850' to 600'</b>		
<b>3:00</b>	<b>3:20</b>	<b>Cemented @ 600' with 25' SX Halliburton cement</b>	<b>1/3</b>	
<b>3:20</b>	<b>4:00</b>	<b>Lay down D.P. &amp; Kelly</b>		

TOUR NO.	FROM	TO	FORMATION	EMPLOYEE	Occupation	HOURS	MUD USED	SKS.
<b>3</b>				<b>Fred ...</b>	<b>DRLR.</b>			
HRS. RUN				<b>Bill ...</b>	<b>DKM.</b>			
HRS. LOST				<b>Don ...</b>	<b>HLP.</b>			
				<b>Rex Flanagan</b>	<b>HLP.</b>			
BIT TYPE	SET NO.	HRS. RUN	FOOTAGE ON BIT	CONE NO.				
BIT TYPE	SET NO.	HRS. RUN	FOOTAGE ON BIT	CONE NO.	CORE HEAD NO.	DEFLECTION:		

TIME		REMARKS	COMPANY TIME	
FROM	TO		W PIPE	WO PIPE
<b>4:00</b>	<b>5:00</b>	<b>Tear out Blow out Preventers</b>		
<b>5:00</b>	<b>5:30</b>	<b>Cemented from bottom of collar to 30' down with 10 SX Halliburton cement</b>		
<b>5:30</b>	<b>12:</b>	<b>Tear down &amp; Drain up.</b>		

Approved by Field Superintendent  
*[Signature]*

15-081-10104-0000

DRILLER'S LOG

W. C. McBride, Inc. and  
Braden Drilling, Inc. et al  
EUBANK "D" #1  
C NW/4 NW/4 Sec. 23-28S-34W,  
Haskell County, Kansas

Commenced: November 26, 1959

Completed: December 20, 1959

Set 8 5/8" surface casing at 843  
feet and cemented with 450 sacks  
Pozmix with 2% c.c.

Clay	160 Feet
Sand and clay	240
Sand and gravel	500
Shale and shells	859
Redbed, shale and Shells	1035
Redbed shale	1385
Sand and shale	1520
Shale and shells	1820
Anhydrite	1864
Shale and shells	2425
Lime and shale	2560
Lime	2685
Lime and shale	2855
Lime	3395
Lime with chalk	3964
Lime	4254
Lime and shale	4269
Lime	4490
Lime and shale	4645
Lime	4775
Lime and shale	4825
Lime	4965
Lime and shale	5040
Lime	5157
Lime and shale	5233
Lime	5261
Lime and shale	5402
Shale and sand	5427
Lime and shale	5456
Sand and shale	5470
Lime and shale	5510
Lime and sand	5535
Lime and shale	5621
Lime	5715 Total Depth

RECEIVED  
STATE CORPORATION COMMISSION  
DEC 24 1959  
CONSERVATION DIVISION  
Wichita, Kansas

I hereby certify that this is a true and correct log of the above  
captioned well, as shown by the daily drilling reports.

BRADEN DRILLING, INC.

By F. M. Callaway  
F. M. Callaway

Subscribed and sworn to before me this 22nd day of December, 1959.

Helen Schultz  
Helen Schultz, Notary Public

My commission expires March 21, 1962.