


WELL PLUGGING RECORD

Give All Information Completely
Make Required Affidavit
Mail or Deliver Report to:
Conservation Division
State Corporation Commission
212 North Market, Insurance Bldg.
Wichita, Kansas

Haskell County, Sec. 23 Twp. 28 S Rge. 34 W (E) (W)

Location as "NE/CNWxSWx" or footage from lines C - SW 1/4 - SE 1/4
Lease Owner J.A. Chapman
Lease Name Eubank Well No. 1
Office Address Box 911 Tulsa Oklahoma.
Character of Well (completed as Oil, Gas or Dry Hole) Dry Hole
Date well completed December 23 19 58
Application for plugging filed 2 " 19
Application for plugging approved 19
Plugging commenced December 24 19 58
Plugging completed January 24 19 59
Reason for abandonment of well or producing formation Dry Hole

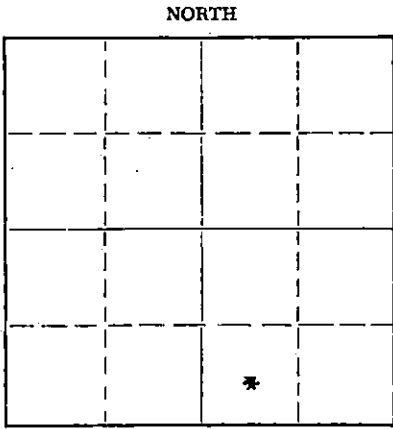

Locate well correctly on above Section Plat

If a producing well is abandoned, date of last production 19
Was permission obtained from the Conservation Division or its agents before plugging was commenced? YES

Name of Conservation Agent who supervised plugging of this well Mr M.A. Reeves Garden City Kansas.
Producing formation Dry Hole Depth to top Bottom Total Depth of Well 5604 Feet
Show depth and thickness of all water, oil and gas formations.

OIL, GAS OR WATER RECORDS

CASING RECORD

FORMATION	CONTENT	FROM	TO	SIZE	PUT IN	PULLED OUT
	Run 60 Joints Cemented with by Halliburton	1884.38 Feet	2950'	8 5/8" od. 24# Pozmix cement from top to bottom (Casing Left in Hole)	J55 Casing	

Describe in detail the manner in which the well was plugged, indicating where the mud fluid was placed and the method or methods used in introducing it into the hole. If cement or other plugs were used, state the character of same and depth placed, from feet to feet for each plug set.

Fill hole with 45Viscosity mud by use of Rotary drilling rig Mud hog pump. Then cement plug was pumped down drill pipe by Halliburton O.W.C.Co. plugging from 2550' TO 2950' with 160 Sacks Pozmix cement. 8 5/8" od. 8sg. cut off 4' below ground level and top 25' filled with portland cement & Location leveled for cultivation.

RECEIVED
STATE CORPORATION COMMISSION

FEB 12 1959

CONSERVATION DIVISION
Wichita, Kansas

(If additional description is necessary, use BACK of this sheet)

Name of Plugging Contractor Holm Drilling Company
Address 1036 E. 38Pl - Tulsa, Okla.

STATE OF Oklahoma, COUNTY OF Tulsa, ss.
A. H. Rogers (employee or owner) or (owner or operator) of the above-described well, being first duly sworn on oath, says: That I have knowledge of the facts, statements, and matters herein contained and the log of the above-described well as filed and that the same are true and correct. So help me God.

(Signature) [Signature]
P. O. Box # 911 - Tulsa, Okla.
(Address)

SUBSCRIBED AND SWORN to before me this 10 day of February, 1959

My commission expires Sept. 17 1959
Mary E Forbes Notary Public.

PLUGGING
FILE SEC. 23 T. 28 R. 34W
BOOK PAGE 9 LINE 3

WELL LOG

15-081-10015-6000

Company J. A. Chapman

Sec. 23 T.28S R. 34W

Farm Eubanks No. 1

Loc. C SW SE

Total Depth 5605

Comm. 12-3-58 Comp. 12-24-58

County Haskell
State Kansas

Contractor Holm Drilling Co., Tulsa, Oklahoma

Casing 1884' - 8 5/8" 24# Smls. W/850 Sks Pozmix

DF - 2998
Elevation KB - 3000
GL - 2990

Production Dry

Figures indicate bottom of formations

Soil & Sd.	149
Sd.	223
Sd. Sh. & Shells	870
Sh. & Shells	1265
Red bed & Shells	1800
Anhydrite	1830
Sh.	1865
Anhydrite	1885
Red bed & Shells	2255
Sh. & Shells	2625
Sh. & Lm.	2810
Lm.	2917
Lm. & Sh.	3108
Lm.	3490
Lm. & Sh.	3656
Lm.	3785
Lm. & Sh.	4015
Lm.	4255
Lm. & Sh.	4340
Lm.	4445
Lm. & Sh.	4540
Hard Lm.	4770
Sh. & Lm.	4870
Lm.	5100
Lm. & Sh.	5155
Sh. & Lm.	5215
Lm.	5240
Lm. & Sh.	5340
Sh. & Lm.	5360
Sh.	5400
Lm. & Sh.	5510
Lm.	5605

REMARKS

12-15-58 D.S.T. No. 1 by Halliburton OWC from 4361 to 4391 - Good blow to surface, recovered 60' oil & gas cut mud, 330' very slightly oil & gas cut salt water, 180' salt water.

12-21-58 D.S.T. No. 2 by Halliburton OWC from 5342' to 5360' - Very weak blow through test. Recovered 10 ft. Drilling Mud. Well Temp. 126°.

12-23-58 - Electric & Contact Log By Welex, Inc. to T.D. 5604.

12-24-58 - Cement Plug by Halliburton Oil Well Cementing Company Plug @ 2550' to 2950', with 160 sacks Pozmix #1 Cement.

State of Oklahoma
County of Tulsa

ss:

I, A. H. Rogers of Tulsa, Oklahoma

upon oath state that the above and foregoing is a true and correct copy of the log of the Eubanks well #1.

Subscribed and sworn to before me this 10th day of February 19 59

My Commission Expires: Sept. 12, 1959

Mary E. Jervis
Notary Public

PLUGGING
 FILE SEC. 23 T. 28 R. 34W
 BOOK PAGE 9 LINE 3

RECEIVED
 STATE CORPORATION COMMISSION
 FEB 12 1959
 CONSERVATION DIVISION
 Wichita, Kansas