

WELL PLUGGING RECORD

15-081-10048-0000

Give All Information Completely
Make Required Affidavit
Mail or Deliver Report to:
Conservation Division
State Corporation Commission
211 No. Broadway
Wichita, Kansas

Haskell County, Sec. 27 Twp. 28 Rge. 34 (E) W (W)

Location as "NE/CNW/SW" or footage from lines. C NW NW

Lease Owner. W. J. Coppinger

Lease Name Doerksen Well No. 2

Office Address Wichita, Kansas

Character of Well (completed as Oil, Gas or Dry Hole)

Date well completed 19

Application for plugging filed 19

Application for plugging approved 19


Plugging commenced 9-21-64 19

Plugging completed 9-22-64 19

Reason for abandonment of well or producing formation Depleted.

If a producing well is abandoned, date of last production 19

Was permission obtained from the Conservation Division or its agents before plugging was commenced? yes

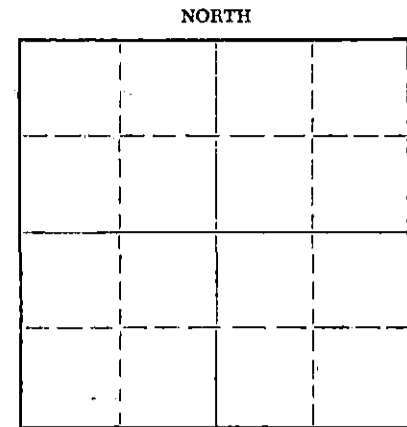

Locate well correctly on above Section Plat

Name of Conservation Agent who supervised plugging of this well Hugh Scott

Producing formation Depth to top Bottom Total Depth of Well 5650 Feet

Show depth and thickness of all water, oil and gas formations.

OIL, GAS OR WATER RECORDS

CASING RECORD

FORMATION	CONTENT	FROM	TO	SIZE	PUT IN	PULLED OUT
				8-5/8"	772'	None
				4-1/2"	5650'	1380'

Describe in detail the manner in which the well was plugged, indicating where the mud fluid was placed and the method or methods used in introducing it into the hole. If cement or other plugs were used, state the character of same and depth placed, from feet to feet for each plug set.

Checked hole to 5650', dumped 10 sacks of cement from 5000' to 4900', pulled 4 1/2" casing, bailed fluid to 700', mudded hole from 4900' to 700' and dumped 35 sacks of cement from 700' to 600'. Mudded hole from 600' to 55', set rock bridge to 45' and dumped 15 sacks of cement to base of cellar.

RECEIVED
STATE CORPORATION COMMISSION

9-28-64 SEP 28 1964

CONSERVATION DIVISION
Wichita, Kansas

PLUGGING COMPLETE.

(If additional description is necessary, use BACK of this sheet)
Name of Plugging Contractor KNIGHT CASING PULLING COMPANY
Address CHASE, KANSAS

STATE OF KANSAS, COUNTY OF RICE, ss.
Noel J. Knight (employee of owner) or (owner) of the above-described well, being first duly sworn on oath, says: That I have knowledge of the facts, statements, and matters herein contained and the log of the above-described well as filed and that the same are true and correct. So help me God.

(Signature) Noel J. Knight
Chase, Kansas
(Address)

SUBSCRIBED AND SWORN TO before me this 24th day of September, 1964

My commission expires May 20, 1968 Milton J. Volin Notary Public.