


STATE OF KANSAS
STATE CORPORATION COMMISSION

15-081-10222-0000

WELL PLUGGING RECORD

Give All Information Completely
Make Required Affidavit
Mail or Deliver Report to
Conservation Division
State Corporation Comm.
245 North Water
Wichita, KS 67202

Haskell County. Sec. 29 Twp. 28 Rge. 34 E/W
Location as "NE/CNW $\frac{1}{2}$ SW $\frac{1}{2}$ " or footage from lines _____

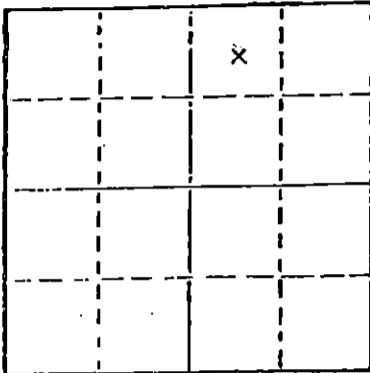

Locate well correctly on above Section Plat

C NW NE
Lease Owner Ashland Exploration Inc.
Lease Name J.D.G. Stucky Well No. 2
Office Address Box 127, Satanta, Kansas 67870
Character of Well (Completed as Oil, Gas or Dry Hole) _____

Oil
Date Well completed August 28, 1958
Application for plugging filed January 22, 1979
Application for plugging approved January 25, 1979
Plugging commenced 4-5 1979
Plugging completed 4-9 1979

Reason for abandonment of well or producing formation _____
Non Productive
If a producing well is abandoned, date of last production _____ 19 _____

Was permission obtained from the Conservation Division or its agents before plugging was commenced? _____ yes

Name of Conservation Agent who supervised plugging of this well Mr. Thomas
Producing formation Marmaton + zones ^{2 Lansing} Depth to top 4511' Bottom 5470' Total Depth of Well 5480'
Show depth and thickness of all water, oil and gas formations.

OIL, GAS OR WATER RECORDS

CASING RECORD

FORMATION	CONTENT	FROM	TO	SIZE	PUT IN	PULLED OUT
Surface				8 5/8"	1339'	0'
Production				5 1/2"	5478'	1450'

Describe in detail the manner in which the well was plugged, indicating where the mud fluid was placed and the method or methods used in introducing it into the hold. If cement or other plugs were used, state the character of same and depth placed, from _____ feet to _____ feet for each plug set.

Pumped 2 sacks bulls & 20 sacks cement to 4200' & pressured to 750 lbs.
Dis placed to 1350'
Pumped 35 sacks cement 1350' to 1250'
Displaced to 40'
Put bridge & 10 sacks cement 40' to 0'
Cut off 8 5/8" 42" below ground level

RECEIVED
STATE CORPORATION COMMISSION

APR 17 1979

CONSERVATION DIVISION
Wichita, Kansas

(If additional description is necessary, use BACK of this sheet)

Name of Plugging Contractor Midwest Casing Pulling
Box F, Sublette, Kansas 67877 Permit # 766

STATE OF KANSAS COUNTY OF HASKELL, ss.
I Edgar J. Eves (employee of owner) or (owner or operator)
of the above-described well, being first duly sworn on oath, says: That I have knowledge of the facts, statements, and matters herein contained and the log of the above-described well as filed and that the same are true and correct. So help me God.

(Signature)

Edgar J. Eves
Box F, Sublette, Kansas 67877
(Address)

SUBSCRIBED AND SWORN TO before me this 10th day of April, 1979

Sandra L. Eves
Notary Public.

My commission expires 12-6-80

