


WELL PLUGGING RECORD

Give All Information Completely
Make Required Affidavit
Mail or Deliver Report to:
Conservation Division
State Corporation Commission
212 North Market, Insurance Bldg.
Wichita, Kansas

HASKELL County. Sec. 29 Twp. 28S Rge. 34W (#) (W)
Location as "NE/CNW/SW" or footage from lines. C NE SE
Lease Owner PETROLEUM, INC.
Lease Name LIGHTCAP Well No. 2
Office Address ROUTE 2, GREAT BEND, KANSAS
Character of Well (completed as Oil, Gas or Dry Hole) DRY HOLE
Date well completed AUGUST 14 1960
Application for plugging filed AUGUST 14 1960
Application for plugging approved AUGUST 14 1960
Plugging commenced AUGUST 14 1960
Plugging completed AUGUST 14 1960
Reason for abandonment of well or producing formation NO PRODUCIBLE ZONES
If a producing well is abandoned, date of last production NONE 19
Was permission obtained from the Conservation Division or its agents before plugging was commenced? YES

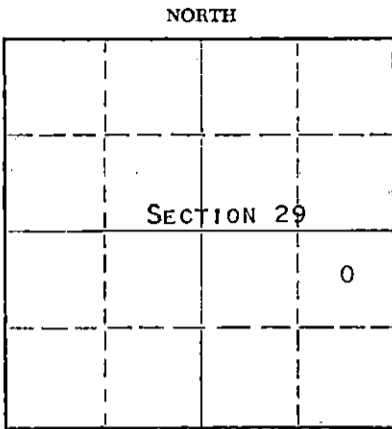

Locate well correctly on above Section Plat

Name of Conservation Agent who supervised plugging of this well MR. FRANK BROADFOOT
Producing formation Depth to top Bottom Total Depth of Well 5620 Feet
Show depth and thickness of all water, oil and gas formations.

OIL, GAS OR WATER RECORDS

CASING RECORD

FORMATION	CONTENT	FROM	TO	SIZE	PUT IN	PULLED OUT
				9-5/8"	718'	NONE

Describe in detail the manner in which the well was plugged, indicating where the mud fluid was placed and the method or methods used in introducing it into the hole. If cement or other plugs were used, state the character of same and depth placed, from feet to feet for each plug set.

MUDDED UP WITH HEAVY MUD TO 2850' FOLLOWED BY WOODEN PLUG. PLACED 150 SACKS OF CEMENT TO 2550'. MUDDED UP WITH HEAVY MUD TO 650' FOLLOWED BY WOODEN PLUG. PLACED 25 SACKS OF CEMENT THROUGH DRILL PIPE ON TOP OF WOODEN PLUG. MUDDED UP WITH HEAVY MUD TO 40' FOLLOWED BY WOODEN PLUG. PLACED 10 SACKS OF CEMENT ON TOP OF WOODEN PLUG TO BASE OF WELL CELLAR.

RECEIVED
CORPORATION COMMISSION
AUG 19 1960
CONSERVATION DIVISION
Wichita, Kansas

(If additional description is necessary, use BACK of this sheet)
Name of Plugging Contractor GARVEY DRILLING COMPANY
Address ROUTE 2, GREAT BEND, KANSAS

STATE OF KANSAS COUNTY OF BARTON, ss.
DON SEARLE (employee of owner) or (~~owner or operator~~) of the above-described well, being first duly sworn on oath, says: That I have knowledge of the facts, statements, and matters herein contained and the log of the above-described well as filed and that the same are true and correct. So help me God.
(Signature) Don Searle
ROUTE 2, GREAT BEND, KANSAS
(Address)

SUBSCRIBED AND SWORN TO before me this 18TH day of AUGUST, 1960

My commission expires NOVEMBER 12, 1962 Frank Broadfoot Notary Public.



WELL LOG

15-081-10184-0000

COMPANY PETROLEUM, INCORPORATED

SEC. 29 T. 28S R. 34W

FARM LIGHTCAP

NO. 2

LOC. C-NE, SE


TOTAL DEPTH 5620'

COUNTY HASKELL CO., KANSAS

COMM. July 20, 1960

COMP. August 14, 1960

CONTRACTOR GARVEY DRILLING COMPANY

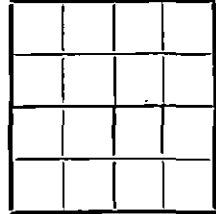

CASING 9 5/8" @ 718' w/550 sax.

ELEVATION 3019' DF

PRODUCTION D & A

FIGURES INDICATE BOTTOM OF FORMATIONS

135	Surface clay
718	Surface clay, sand & shells
1675	Shale, shells w/sand streaks
2795	Lime & shale
2909	Chalky lime & shale
3120	Lime & shale
3235	Chalky lime & shale
4610	Lime & shale
4658	Cherty lime & shale
5155	Lime & shale
5255	Shale & lime
5620	Lime & shale
5620	T. D.

RECEIVED
STATE CORPORATION COMMISSION
AUG 19 1960
CONSERVATION DIVISION
Kansas

State of KANSAS }
County of BARTON } ss.

I, VERNE A. MORRIS of GARVEY DRILLING COMPANY

upon oath state that the above and foregoing is a true and correct copy of the log of the #2 LIGHTCAP well

Verne A. Morris

Subscribed and sworn to before me this 17th day of August 19 60

My Commission Expires: November 12, 1962

[Signature]
NOTARY PUBLIC