


Give All Information Completely
Make Required Affidavit
Mail or Deliver Report to:
Conservation Division
State Corporation Commission
211 No. Broadway
Wichita, Kansas

WELL PLUGGING RECORD

15-081-10183-0000

NORTH

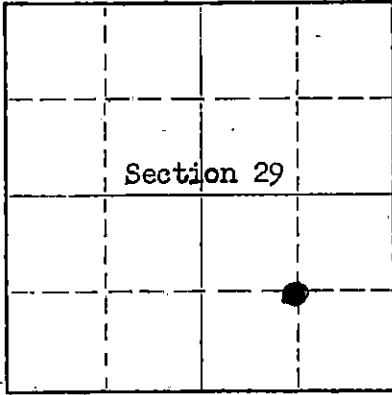

Locate well correctly on above
Section Plat

Haskell County. Sec. 29 Twp. 28S- Rge. 34 ~~W~~ W
Location as "NE/CNW&SW" or footage from lines. C-SE-SE
Lease Owner Petroleum, Inc.
Lease Name Lightcap Well No. 1
Office Address P. O. Box 1255, Liberal, Kansas
Character of Well (completed as Oil, Gas or Dry Hole) Oil Well
Date well completed November 9 1959
Application for plugging filed November 11 1964
Application for plugging approved November 12 1964
Plugging commenced December 2 1964
Plugging completed December 8 1964
Reason for abandonment of well or producing formation
Depletion of producible zones
If a producing well is abandoned, date of last production November 16 1964
Was permission obtained from the Conservation Division or its agents before plugging was commenced? Yes

Name of Conservation Agent who supervised plugging of this well Hugh Scott, Sublette, Kansas
Producing formation Chester Depth to top 5438' Bottom 5454' Total Depth of Well 5576 Feet
Show depth and thickness of all water, oil and gas formations.

OIL, GAS OR WATER RECORDS

CASING RECORD

FORMATION	CONTENT	FROM	TO	SIZE	PUT-IN	PULLED OUT
Chester	Oil	5438'	5454'	8-5/8"	1863'	None
				4-1/2"	5615'	2634'

Describe in detail the manner in which the well was plugged, indicating where the mud fluid was placed and the method or methods used in introducing it into the hole. If cement or other plugs were used, state the character of same and depth placed, from _____ feet to _____ feet for each plug set.

Pumped 20 sacks of cement from 5576' to 5300'. Mudded up with heavy mud to 2400'. Pumped 20 sacks of cement from 2400' to 2300'. Mudded up with heavy mud to 700'. Pumped 35 sacks of cement from 700' to 600'. Mudded up with heavy mud to 45'. Dumped 15 sacks of cement from 45' to base of well cellar.

RECEIVED
STATE CORPORATION COMMISSION

DEC 17 1964

CONSERVATION DIVISION
Wichita, Kansas

(If additional description is necessary, use BACK of this sheet)

Name of Plugging Contractor Sargent's Casing Pulling
Address 121 West 9th, Liberal, Kansas

STATE OF Kansas COUNTY OF Seward, ss.
Harold L. Young, Dist. Prod. Foreman (employee of owner) or (owner or operator) of the above-described

well, being first duly sworn on oath, says: That I have knowledge of the facts, statements, and matters herein contained and the log of the above-described well as filed and that the same are true and correct. So help me God.

(Signature) Harold L. Young

Box 1255, Liberal, Kansas

(Address)

SUBSCRIBED AND SWORN TO before me this 16th day of December 1964

Linda K. Coffey
Notary Public.

My commission expires April 9, 1968

WELL LOG

15-081-10183-0000

COMPANY **PETROLEUM, INCORPORATED**

SEC. 29 T. 28 R. 34W

FARM **LIGHTCAP** NO. 1

LOC. **C-SE, SE**


TOTAL DEPTH **5620'**

COUNTY **HASKELL CO., KANSAS**

COMM. **October 3, 1959**

COMP. **OK October 29, 1959**

CONTRACTOR **GARVEY DRILLING COMPANY**

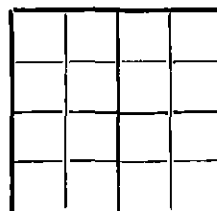

CASING **8 5/8" @ 1863' W/1000 sax.**
4 1/2" @ 5615' W/150 sax.

ELEVATION **3018' DF**

PRODUCTION **Chester**

FIGURES INDICATE BOTTOM OF FORMATIONS

140	Clay & sand
570	Sand & gravel
690	Shale
760	Red bed
1220	Red bed & shells
1270	Red bed & shale
1370	Red bed & gyp
1545	Sand
1645	Red bed & gyp
1815	Red bed & shells
1862	Gyp & red bed
1867	Anhydrite
1975	Anhydrite & shells
2255	Red bed & shells
2650	Lime & shale
2815	Lime, shab & dolomite
3665	Lime & shale
3850	Chalky lime
4190	Lime & shale
4275	Lime & chert w/chalk streaks
4340	Lime & shale
4410	Lime
4530	Lime & shale
4543	Lime
4640	Lime & shale
4775	Lime
5022	Lime & shale
5160	Lime
5217	Shale
5229	Sand
5280	Lime & shale
5355	Shale & lime
5380	Shale & sandy lime
5452	Lime & shale
5475	Lime
5507	Lime & shale
5620	Lime

State of KANSAS }
County of BARTON } ss: 5620

T. D.

RECEIVED
STATE CORPORATION COMMISSION

DEC 17 1964

CONSERVATION DIVISION
Wichita, Kansas

I, VERNE A. MORRIS of GARVEY DRILLING COMPANY

upon oath state that the above and foregoing is a true and correct copy of the log of the #1 LIGHTCAP well.

Verne A. Morris
Arthur J. Webb
NOTARY PUBLIC

Subscribed and sworn to before me this 14th day of November 19 59

My Commission Expires: April 14, 1963