


Give All Information Completely
Make Required Affidavit
Mail or Deliver Report to:
Conservation Division
State Corporation Commission
211 No. Broadway
Wichita, Kansas

WELL PLUGGING RECORD 15-081-00042-0000

NORTH

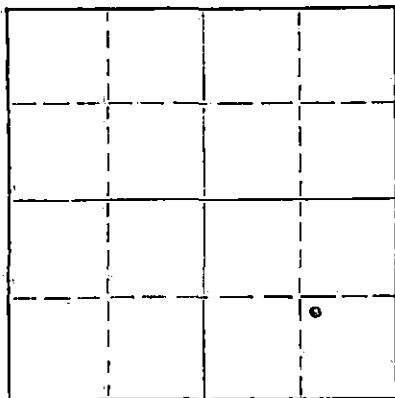

Locate well correctly on above Section Plat

Haskell County. Sec. 15 Twp. 28 S Rge. 31 W (E) (W)
Location as "NE/CNWxSWx" or footage from lines. 1250' FS & EL
Lease Owner. Hamilton Brothers Inc.
Lease Name. Mattie E. Henry Well No. I-15
Office Address. 1517 Denver Club Bldg. Denver 2, Colo.
Character of Well (completed as Oil, Gas or Dry Hole) Gas (Not commercial)
Date well completed _____ 19____
Application for plugging filed Oct. 17, 19 62
Application for plugging approved Oct. 18, 19 62
Plugging commenced 4:30 P.M. Oct. 18, 19 62
Plugging completed 7:00 P.M. Oct. 18, 19 62
Reason for abandonment of well or producing formation Not sufficient quantity of gas
If a producing well is abandoned, date of last production _____ 19____
Was permission obtained from the Conservation Division or its agents before plugging was commenced? Yes

Name of Conservation Agent who supervised plugging of this well Hugh Scott
Producing formation Krider Depth to top 2739 Bottom 2780 Total Depth of Well 2785 Feet
Show depth and thickness of all water, oil and gas formations.

OIL, GAS OR WATER RECORDS

CASING RECORD

FORMATION	CONTENT	FROM	TO	SIZE	PUT IN	PULLED OUT
Krider	gas & water	0	648	8-5/8"	648	0
		0	2785	4-1/2"	2785	0

Describe in detail the manner in which the well was plugged, indicating where the mud fluid was placed and the method or methods used in introducing it into the hole. If cement or other plugs were used, state the character of same and depth placed, from _____ feet to _____ feet for each plug set.

35 sacks common (Portland) cement mixed and pumped in by The Halliburton Co. to form plug from 2330-2782'. Drilling mud from 175-2330', followed by 15 sack cement plug from 0-175'.

RECEIVED
STATE CORPORATION COMMISSION
OCT 23 1962 10-23-62
CONSERVATION DIVISION
Wichita, Kansas

(If additional description is necessary, use BACK of this sheet)

Name of Plugging Contractor The Halliburton Co.
Address Liberal, Kansas

STATE OF Kansas, COUNTY OF Seward, ss.
Haskell Fleetwood (employee of owner) or (owner or operator) of the above-described

well, being first duly sworn on oath, says: That I have knowledge of the facts, statements, and matters herein contained and the log of the above-described well as filed and that the same are true and correct. So help me God.

(Signature) Haskell Fleetwood
1316 Fairview Liberal, Kan. (Address)

SUBSCRIBED AND SWORN to before me this 22 day of October, 19 62

MY COMMISSION
EXPIRES FEB. 3, 1965

My commission expires _____

Leslie C. Spaulding
Notary Public.