

STATE OF KANSAS
STATE CORPORATION COMMISSION

Give All Information Completely
Make Required Affidavit
Mail or Deliver Report to:
Conservation Division
State Corporation Commission
212 No. Market
Wichita, Kansas

WELL PLUGGING RECORD

Haskell County, Sec. 29 Twp. 28S Rge. (E) 31 (W)

Location as "NE/CNW/SW" or footage from lines C SE/4 NW/4

Lease Owner Jones & Pellow Oil Co.

Lease Name HAINLINE Well No. 1

Office Address 101 NE 26th St., Oklahoma City, Oklahoma 73105

Character of Well (completed as Oil, Gas or Dry Hole) Dry Hole

Date well completed April 10 1969

Application for plugging filed 19

Application for plugging approved 19


Plugging commenced April 10 1969

Plugging completed April 10 1969

Reason for abandonment of well or producing formation Dry Hole

If a producing well is abandoned, date of last production 19

Was permission obtained from the Conservation Division or its agents before plugging was commenced? Yes

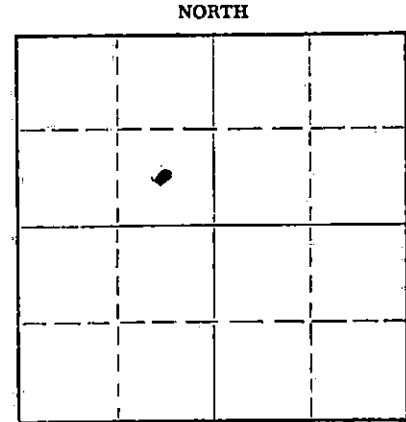

Locate well correctly on above Section Plat

Name of Conservation Agent who supervised plugging of this well Edgar J. Eves

Producing formation Depth to top Bottom Total Depth of Well 5550 Feet

Show depth and thickness of all water, oil and gas formations.

OIL, GAS OR WATER RECORDS

CASING RECORD

FORMATION	CONTENT	FROM	TO	SIZE	PUT IN	PULLED OUT
				8-5/8	1849'	None

Describe in detail the manner in which the well was plugged, indicating where the mud fluid was placed and the method or methods used in introducing it into the hole. If cement or other plugs were used, state the character of same and depth placed, from feet to feet for each plug set.

Plugged with 30 sx regular cement @ 900'. Cemented with 15 sx plug 15' below ground level.

RECEIVED
STATE CORPORATION COMMISSION
APR 24 1969
CONSERVATION DIVISION
Wichita, Kansas

(If additional description is necessary, use BACK of this sheet)
Name of Plugging Contractor Garvey Drilling Co.
Address Great Bend, Kansas

STATE OF Kansas COUNTY OF Haskell ss.
Edward D. Keleher (employee of owner) or (owner or operator) of the above-described well, being first duly sworn on oath, says: That I have knowledge of the facts, statements, and matters herein contained and the log of the above-described well as filed and that the same are true and correct. So help me God.

(Signature) Edward D. Keleher
101 NE 26th St., Oklahoma City, Oklahoma 73105
(Address)

SUBSCRIBED AND SWORN TO before me this 23rd day of April, 1969

My commission expires 8-26-72 Notary Public.

WELL LOG

15-081-20014-0000

COMPANY Jones & Pellow

SEC. 29 T. 28S R. 31W

FARM Mainline No. 1

Loc. SE NW


TOTAL DEPTH 5550'

COUNTY Haskell, Kansas

COMM. 3-26-69 COMP. 4-10-69

CONTRACTOR Garvey Drilling Company

CASING 6 5/8" @ 1845' w/875 sx

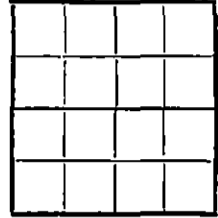

ELEVATION

PRODUCTION D & A

FIGURES INDICATE BOTTOM OF FORMATIONS

- 530' Surface Sand & Clay
- 976' Surface Sand & Red Bed
- 1185' Red Bed & Sand
- 1720' Sand & Red Bed
- 1739' Red Bed
- 1846' Anhydrite
- 2200' Red Bed & Shale
- 2850' Shale
- 4136' Lime & Shale
- 4144' Lime, Shale & Chalk
- 5550' Lime & Shale
- 5550' RTD

RECEIVED
 STATE CORPORATION COMMISSION
 JUN 10 1969
 CONSERVATION DIVISION
 Wichita, Kansas

State of Kansas }
 County of Barton } as

I, Charlene Marker of Garvey Drilling Company

upon oath state the above and foregoing is a true and correct copy of the log of the Mainline No. 1 well.

Subscribed and sworn to before me this 11th day of April 1969

My Commission Expires: November 5, 1969

Charlene Marker
Richard L. Doy
 NOTARY PUBLIC