


WELL PLUGGING RECORD

Give All Information Completely  
Make Required Affidavit  
Mail or Deliver Report to:  
Conservation Division  
State Corporation Commission  
800 Bitting Building  
Wichita, Kansas

NORTH

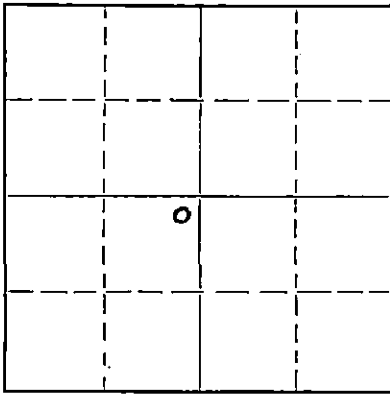

Locate well correctly on above Section Plat

Haskell County. Sec. 4 Twp. 28 Rge. 32 (E) (W)  
Location as "NE/CNW $\frac{1}{4}$ SW $\frac{1}{4}$ " or footage from lines 2310' from South and 2310' from West.  
Lease Owner Champlin Refining Company  
Lease Name Elliott Well No. 1  
Office Address P. O. Drawer 552, Enid, Oklahoma  
Character of Well (completed as Oil, Gas or Dry Hole) Dry Hole  
Date well completed August 23 19 50  
Application for plugging filed September 5 19 50  
Application for plugging approved September 6 19 50  
Plugging commenced September 17 19 50  
Plugging completed November 3 19 50  
Reason for abandonment of well or producing formation Dry Hole

If a producing well is abandoned, date of last production Not Produced 19  
Was permission obtained from the Conservation Division or its agents before plugging was commenced? Yes

Name of Conservation Agent who supervised plugging of this well R. J. Phillippe  
Producing formation See below Depth to top Bottom Total Depth of Well 2830 Feet  
Show depth and thickness of all water, oil and gas formations.

OIL, GAS OR WATER RECORDS

CASING RECORD

Formation	Content	From	To	Size	Put In	Pulled Out
Sand & Gravel	Water	260	320	10 3/4" OD 7" OD	620 2830	None None
Dolomite	Not Tested	2707	2721			
"	Show of Gas	2728	2751			
"	" " "	2754	2778			
"	" " "	2801	2820			

Describe in detail the manner in which the well was plugged, indicating where the mud fluid was placed and the method or methods used in introducing it into the hole. If cement or other plugs were used, state the character of same and depth placed, from feet to feet for each plug set.

Dumped 25 sacks cement with cable tool dump bailer. Top of cement 2786 by Halliburton Wire Line measurer. Dumped 12 sacks Cal-Seal with Halliburton dump bailer. Top of Cal-Seal 2708 by Halliburton Wire Line measure. Dumped 2 sacks cement with Halliburton dump bailer. Top of cement 2693 by Halliburton Wire Line measure.

Filled 7" pipe to top by pumping rotary mud with Halliburton pump trucks. Displaced top 30' of rotary mud with cement by Halliburton pump truck. Cut off 10 3/4" and 7" casing 6 ft. below ground and capped by welding on boiler plate. 10 3/4" and 7" casing cemented to top when run and no attempt was made to pull casing.

11-7-50

RECEIVED  
STATE CORPORATION COMMISSION

NOV 7 - 1950

(If additional description is necessary, use BACK of this sheet)

Correspondence regarding this well should be addressed to Champlin Refining Company, Conservation Department, Address Drawer 552, Enid, Oklahoma, Wichita, Kansas

STATE OF Kansas, COUNTY OF Finney, ss.  
J. E. Hodges (employee of owner) or (owner or operator) of the above-described well, being first duly sworn on oath, says: That I have knowledge of the facts, statements, and matters herein contained and the log of the above-described well as filed and that the same are true and correct. So help me God.

(Signature) J. E. Hodges  
CHAMPLIN REFINING CO.  
KNOX BUILDING, ROOM NO. 8  
401 1/2 NORTH MAIN ST.  
GARDEN CITY, KANSAS  
(Address)

SUBSCRIBED AND SWORN to before me this 3rd day of November, 1950  
Helen M. Stowell  
Notary Public.

My commission expires Aug. 10 - 1954 22-7377-B 4-40-10M

PLUGGING  
FILE SEC 4 T 28 R 32 W  
BOOK PAGE 26 LINE 1



# CHAMPLIN REFINING COMPANY

ENID, OKLAHOMA

Garden City, Kansas  
September 5, 1950

15-081-00120-0000

WELL LOG, ELLIOTT #1  
Section 4-28-32W  
Haskell County, Kansas

<u>Formation</u>	<u>Content</u>	<u>From</u>	<u>To</u>
Sand & Gravel	Fresh Water	260	320
Dolomite	Not Tested	2707	2721
"	Small Show Gas	2728	2751) 2 Bbls salt water per hour
"	" " "	2754	2778) after acidizing.
"	" " "	2801	2820

Set 620' 103/4" OD casg-cemented to top.

Set 2830' 7" OD casg-cemented to top.

Drilled cement to 2823 1/2'.

Perforated 186 holes thru 7" casg from 2728 to 2776

Small show gas and 2 bbls salt water per hour after acidizing.

Perforated 114 holes thru 7" casg from 2801 to 2820.

Small show gas. No apparent increase in water.

Dumped 25 sacks cement with cable tool dump bailer.

Filled to 2786 by Halliburton wire line measure.

Dumped 12 sacks Cal-Seal with Halliburton dump bailer.

Filled to 2708 by Halliburton wire line measure

Dumped 3 sacks cement with Halliburton dump bailer.

Filled to 2693 by Halliburton wire line measure.

**PLUGGING**  
 FILE SEC 4 T 28 R 32W  
 PAGE 26 LINE 1

RECEIVED  
 SEP 6 X 1950  
 STATE OF OKLAHOMA  
 COMMISSION  
 OIL & GAS