


15-081-00178-0000

STATE OF KANSAS
STATE CORPORATION COMMISSION

WELL PLUGGING RECORD

Give All Information Completely
Make Required Affidavit
Mail or Deliver Report to:
Conservation Division
State Corporation Commission
211 No. Broadway
Wichita, Kansas

Haskell County. Sec. 8 Twp. 28 Rge. (E) 32 (W)
Location as "NE/CNW/SW" or footage from lines 200' S & E from Center
Lease Owner Kansas-Nebraska Natural Gas Company, Inc.
Lease Name June Well No. 1
Office Address P. O. Box 608 Hastings, Nebraska 68901
Character of Well (completed as Oil, Gas or Dry Hole) Gas
Date well completed June 8 19 53
Application for plugging filed March 1 19 66
Application for plugging approved March 2 19 66
Plugging commenced March 3 19 66
Plugging completed March 3 19 66
Reason for abandonment of well or producing formation No longer capable of commercial production
If a producing well is abandoned, date of last production May 19 64
Was permission obtained from the Conservation Division or its agents before plugging was commenced? yes

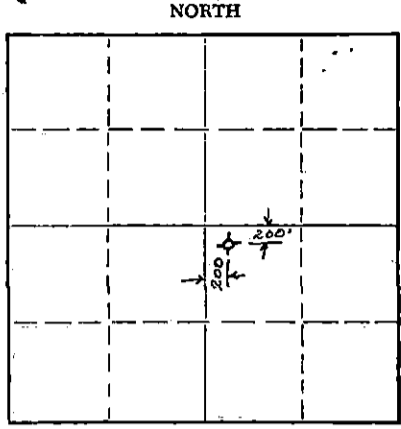

Locate well correctly on above Section Plat

Name of Conservation Agent who supervised plugging of this well Ed Eyes Box F, Sublette, Kansas
Producing formation Herington Krider Depth to top 2708 Bottom 2748 Total Depth of Well 2768 Feet
Show depth and thickness of all water, oil and gas formations.

OIL, GAS OR WATER RECORDS

CASING RECORD

FORMATION	CONTENT	FROM	TO	SIZE	PUT IN	PULLED OUT
Herington, Krider	Gas	2708	2748	7"	2764	1430

Describe in detail the manner in which the well was plugged, indicating where the mud fluid was placed and the method or methods used in introducing it into the hole. If cement or other plugs were used, state the character of same and depth placed, from _____ feet to _____ feet for each plug set.

Mixed 25 sacks cement with pump truck and pumped plug to 2588
Shot Pipe 1942-1517-Loose at 1430'
Pulled 19 Jts, 7" Casing (800')
Mixed 50 sacks cement and pumped down 7" casing for cement plug 630' to 530'
Laid down balance of casing (15 Jts.)
Top plug 20 sacks 40' to 0'

RECEIVED
STATE CORPORATION COMMISSION
MAR 14 1966
CONSERVATION DIVISION
Wichita, Kansas

(If additional description is necessary, use BACK of this sheet)
Name of Plugging Contractor Sargent's Casing Pulling Service,
Address Liberal, Kansas

STATE OF Nebraska, COUNTY OF Adams, ss.
Thomas C. Swanson (employee of owner) or (~~owner or operator~~) of the above-described well, being first duly sworn on oath, says: That I have knowledge of the facts, statements, and matters herein contained and the log of the above-described well as filed and that the same are true and correct. So help me God.

(Signature) Thomas C. Swanson
P. O. Box 608, Hastings, Nebraska
(Address)

SUBSCRIBED AND SWORN to before me this 11th day of March, 19 66

My commission expires January 23, 1970

F. S. White
Notary Public.

HONAKER DRILLING COMPANY
GREAT BEND, KANSAS

15-081-00178-0000

DRILLERS LOG

June #1
Loc: 200S and 200E of Center
Sec: 8-28-32
Haskell Co., Kansas

Comm: 6-28-53
Comp: 6-3-53
Total Depth: 2772'

Operator: Kansas-Nebraska Nat'l Gas Co., Inc.
Contractor: Honaker Drilling Co.

Casing: 10 3/4" 616'
7" 2765'

0	40	Top Soil, Sand & Clay	
40	310	Sand	
310	360	Sandy Clay	
360	470	Sand & Gravel	
470	500	Clay	
500	580	Sand & Gravel	
580	725	Blue Shale	10 3/4" Casing cemented at 616' with 300 sacks cement and 3 sacks calcium chloride.
725	960	Red Rock & Shale	
960	1045	Red Bed & Shale	
1045	1380	Red Rock & Gyp	
1380	1725	Red Rock & Sand	
1725	1820	Salt & Sand	
1820	2150	Red Rock & Shale	
2150	2485	Lime & Shale	7" Casing cemented at 2765' with 200 sacks cement.
2485	2560	Anhydrite & Shale	
2560	2772	Lime & Shale	
2772		Total Rotary Depth	

I certify that this is the true and correct copy of the above log, to the best of my knowledge.

Joe J. Honaker

Subscribed and sworn to before me this 8 day of June 1953.

Walter D. Parker
Notary Public

My Commission Expires June 25, 1955.

RECEIVED
STATE CORPORATION COMMISSION
MAR 30 1966
CONSERVATION DIVISION
Wichita, Kansas