


STATE OF KANSAS
STATE CORPORATION COMMISSION

Form CP-4

Give All Information Completely
Make Required Affidavit
Mail or Deliver Report to:
Conservation Division
State Corporation Commission
212 No. Market
Wichita, Kansas 67202

WELL PLUGGING RECORD

Pratt County, Sec. 2 Twp. 27S Rge. 13 (E) W (W)
Location as "NE/CNW/SW" or footage from lines C N $\frac{1}{2}$ S $\frac{1}{2}$ SE $\frac{1}{4}$
Lease Owner Bowers Drilling Co.
Lease Name Sheegog 'A' Well No. # 1
Office Address 1434 Wichita Plaza ; Wichita, Ks. 67202
Character of Well (completed as Oil, Gas or Dry Hole) _____
Date well completed _____ 19____
Application for plugging filed September 19 70
Application for plugging approved September 19 70
Plugging commenced September 17 19 70
Plugging completed September 21 19 70
Reason for abandonment of well or producing formation _____

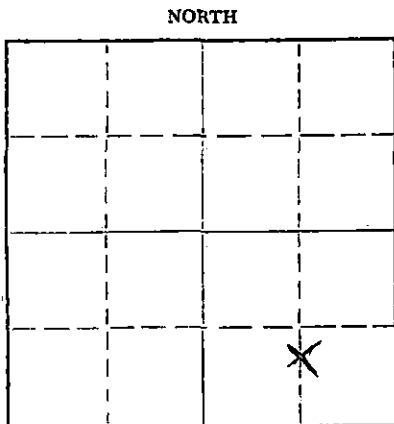

Locate well correctly on above
Section Plat

If a producing well is abandoned, date of last production _____ 19____
Was permission obtained from the Conservation Division or its agents before plugging was commenced? Yes

Name of Conservation Agent who supervised plugging of this well Russell Biberstein
Producing formation _____ Depth to top _____ Bottom _____ Total Depth of Well _____ Feet
Show depth and thickness of all water, oil and gas formations.

OIL, GAS OR WATER RECORDS

CASING RECORD

FORMATION	CONTENT	FROM	TO	SIZE	PUT IN	PULLED OUT
				8 5/8	451	None
				4 1/2	4368	3425

Describe in detail the manner in which the well was plugged, indicating where the mud fluid was placed and the method or methods used in introducing it into the hole. If cement or other plugs were used, state the character of same and depth placed, from _____ feet to _____ feet for each plug set.

September 17, 1970 Plugged off bottom. Dumped sand to 3975'. Mixed and dumped 4 sx of cement to 3925'.
September 21, 1970 Plugged off top. Set 20' rock bridge from 330' to 350'. Filled 8 5/8" surface casing with ready mix concrete from 330' to base of cellar.

RECEIVED
STATE CORPORATION COMMISSION
AUG 25 1972
CONSERVATION DIVISION
Wichita, Kansas

(If additional description is necessary, use BACK of this sheet)

Name of Plugging Contractor RUSS CASING PULLING, INC
Address P. O. BOX 1082 ; GREAT BEND, KANSAS 67530

STATE OF KANSAS, COUNTY OF SEDGWICK, ss.
Emil E. Bowers (employee of owner) or (owner or operator) of the above-described well, being first duly sworn on oath, says: That I have knowledge of the facts, statements, and matters herein contained and the log of the above-described well as filed and that the same are true and correct. So help me God.

(Signature) Emil E. Bowers, President
Bowers Drilling Co. Suite 1434, 125 No. Market
Wichita, Kansas (Address)
September 19 70

SUBSCRIBED AND SWORN TO before me this Sept 22nd day of September, 19 70

Carole A. Young
Notary Public.

My commission expires May 12, 1973

WELL LOG

COMPANY: Bowers Drilling Company, Inc.
 CONTRACTOR: Bowers Drilling Company, Inc.
 FARM: Sheegor A #1
 LOCATION: C N/2 S/2 SE/4
 Sec. 2-27S-13W
 Pratt County, Kansas
 COMMENCED: 4-13-70
 COMPLETED: 4-23-70
 ELEVATION: 1908 Kelly Bushing
 1906 Derrick Floor
 1902 Ground Level

0 - 70	Sand & Clay	
70 - 451	Sand & Red Bed	
451 - 800	Red Bed	
800 - 1160	Red Bed & Shale	Set 8 5/8" csg. @451' w/350 saks
1160 - 3790	Shale & Lime	
3790 - 4200	Lime	
4200 - 4263	Chert & Lime	
4263 - 4292	Shale	
4292 - 4369	Lime	
4369 - 4380	Arbuckle	Set 4 1/2" csg. @4368 w/200 saks
4380	T. D.	

LOG TOPS:

Heebner	3545
Toronto	3564
Douglas	3583
Brown Lime	3711
Lansing	3741
Base/Kansas City	4062
Mississippian	4158
Viola	4206
Simpson Shale	4253
Simpson Dolomite	4262
Simpson Sand	4280
Arbuckle	4364

RECEIVED
 STATE CORPORATION COMMISSION
 SEP 17 1970
 CONSERVATION DIVISION
 Wichita, Kansas

STATE OF KANSAS)
) SS
 COUNTY OF SEDGWICK)

I, Emil E. Bowers, do hereby certify that the above and foregoing is a true and correct copy of the log of the #1 Sheegor A located C N/2 S/2 SE/4 Section 2-27S-13W, Pratt County, Kansas, as reflected by the files of Bowers Drilling Company, Inc.

Emil E. Bowers
 Emil E. Bowers, President

Subscribed and sworn to before me, a Notary Public, in and for the State of Kansas, this 1st. day of May, 1970.

Carole A. Young
 Carole A. Young, Notary Public

My Commission expires May 12, 1970.

