

STATE OF KANSAS
STATE CORPORATION COMMISSION


WELL PLUGGING RECORD

Give All Information Completely
Make Required Affidavit
Mail or Deliver Report to:
Conservation Division
State Corporation Commission
211 No. Broadway
Wichita, Kansas

Pratt County, Sec. 2 Twp. 27 Rge. 13 (W)

Location as "NE/CNW/SW" or footage from lines NW NW NW
Lease Owner Stickle Drilling Company
Lease Name Harrel Well No. 1
Office Address 1027 Union Center, Wichita 2, Kansas
Character of Well (completed as Oil, Gas or Dry Hole) Dry Hole
Date well completed 14 November 19 56
Application for plugging filed 13 November 19 56
Application for plugging approved 13 November 19 56
Plugging commenced 14 November 19 56
Plugging completed 14 November 19 56
Reason for abandonment of well or producing formation _____

NORTH

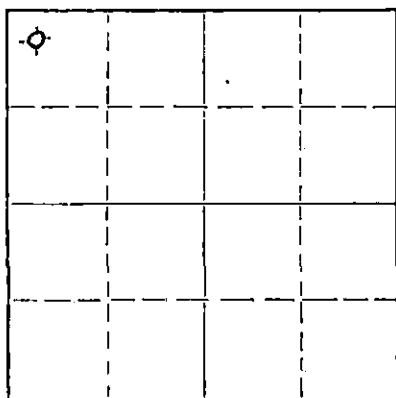

Locate well correctly on above Section Plat

If a producing well is abandoned, date of last production _____ 19____
Was permission obtained from the Conservation Division or its agents before plugging was commenced? yes

Name of Conservation Agent who supervised plugging of this well Mr. M. A. Rives, Pratt, Kansas
Producing formation _____ Depth to top _____ Bottom _____ Total Depth of Well 4437 Feet
Show depth and thickness of all water, oil and gas formations.

OIL, GAS OR WATER RECORDS

CASING RECORD

FORMATION	CONTENT	FROM	TO	SIZE	PUT IN	PULLED OUT
Surface	water	0	approx 200'	13 3/8"	279	none

Describe in detail the manner in which the well was plugged, indicating where the mud fluid was placed and the method or methods used in introducing it into the hole. If cement or other plugs were used, state the character of same and depth placed, from _____ feet to _____ feet for each plug set.

Mixed mud in pits thoroughly with jets and placed heavy rotary mud from total depth to 270 feet through drill pipe.

A Halliburton plug and 1/2 sack of hulls were place at 270 feet with 35 sacks of cement placed on top of this through the drill pipe.

Heavy rotary mud was placed to 20 feet.

A Halliburton plug and 1/4 sack of hulls were placed at 20 feet with 15 sacks of cement placed on top of this through the drill pipe.

(If additional description is necessary, use BACK of this sheet)

Name of Plugging Contractor Stickle Drilling Company
Address 1027 Union Center, Wichita 2, Kansas

STATE OF KANSAS, COUNTY OF SEDGWICK, ss. R. B. Parriott

(Employer, owner or (owner or operator) of the above-described well, being first duly sworn on oath, says: That I have knowledge of the facts, statements, and matters herein contained and the log of the above-described well as filed and that the same are true and correct. So help me God.

(Signature) R. B. Parriott
1027 Union Center, Wichita 2, Kansas
(Address)

SUBSCRIBED AND SWORN to before me this 15th day of November, 1956

My Commission Expires Sept, 14, 1960

My commission expires _____

Notary Public.
STATE CORPORATION COMMISSION
NOV 21 1956
11-21-56
CONSERVATION DIVISION
Wichita, Kansas

PLUGGING
FILE SEC 2 T 27 R 13W
BOOK PAGE 116 LINE 40

Stickle Drilling Company, et al
Tulsa, Oklahoma

Tulsa, Oklahoma
November 16, 1956

CONTRACTOR: Stickle Drilling Company
Drilling Commenced: November 1, 1956
Drilling Completed: November 14, 1956

Harrel #1 - NW NW NW
Section 2-27S-13W,
Pratt County, Kansas.

DRILLERS LOG

Depth Figures Indicate Base of Formation

Sand	40
Sand & Clay	240
Red Bed	525
Sand	650
Red Bed	790
Anhydrite Stringers	815
Shale & Shells	1858
Shale & Lime	2035
Lime & Shale	2320
Shale & Lime	2425
Lime & Shale	2620
Shale	2990
Shale & Lime	3010
Lime & Shale	3170
Shale & Lime	3450
Lime	3529
Lime & Shale	3625
Shale, Lime & Sand	3750
Lime	4192
Chat & Lime	4210
Shale & Chert	4278
Viola	4303
Shale & Lime	4335
Simpson Shale	4383
Shale & Lime	4423
Lime	4437 TD

I, Frank E. Stickle, hereby certify the above to be a true and complete Driller's Log of Stickle Drilling Company, et al, Harrel #1 - NW NW NW - Section 2-27S-13W, Pratt County, Kansas.

PLUGGING
 FILE SEC 2 T 27 R 13W
 BOOK PAGE 116 LINE 40

Frank E. Stickle
Frank E. Stickle

Lillian T. Bonham
Notary Public

RECEIVED
REGISTRATION COMMISSION

February 13, 1956
My Commission Expires

CONSERVATION DIVISION
Wichita, Kansas