


STATE OF KANSAS
STATE CORPORATION COMMISSION

WELL PLUGGING RECORD

Give All Information Completely
Make Required Affidavit
Mail or Deliver Report to:
Conservation Division
State Corporation Commission
800 Bitting Building
Wichita, Kansas

PRATT County, Sec. 2 Twp. 27S Rge. (#) 13(W)

Location as "NE/CNWSW" or footage from lines NE NE SW
Lease Owner SHELL OIL COMPANY
Lease Name C. F. BRIGGEMAN "C" Well No. 1
Office Address BOX 744, GREAT BEND, KANSAS
Character of Well (completed as Oil, Gas or Dry Hole) DRY HOLE
Date well completed SEPTEMBER 17 19 52
Application for plugging filed SEPTEMBER 17 19 52
Application for plugging approved SEPTEMBER 18 19 52
Plugging commenced SEPTEMBER 18 19 52
Plugging completed SEPTEMBER 27 19 52
Reason for abandonment of well or producing formation DRY HOLE

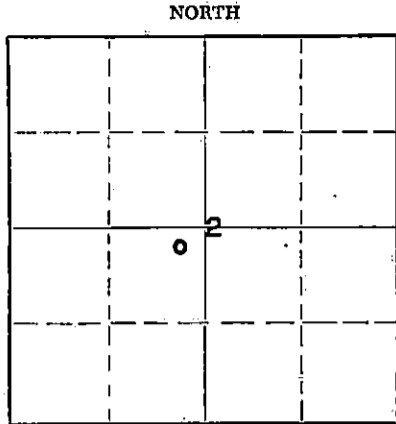

Locate well correctly on above
Section Plat

If a producing well is abandoned, date of last production -- 19
Was permission obtained from the Conservation Division or its agents before plugging was commenced? YES

Name of Conservation Agent who supervised plugging of this well M. A. RIVES
Producing formation ARBUCKLE Depth to top 4286 Bottom Total Depth of Well 4389 Feet
Show depth and thickness of all water, oil and gas formations. PB 3817

OIL, GAS OR WATER RECORDS

CASING RECORD

| FORMATION | CONTENT | FROM | TO | SIZE | PUT IN | PULLED OUT |
|---------------------|--------------------|------|------|--------|--------|------------|
| Arbuckle | Dry | 4286 | 4389 | 8 5/8" | 783' | None |
| Simpson | Dry | 4306 | 4313 | 1 1/2" | 4387' | 2587' |
| " | " | 4282 | 4296 | | | |
| Viola | Dry | 4250 | 4270 | | | |
| Lansing-Kansas City | Trace oil & 7 BWPB | 3986 | 3992 | | | |
| " " " | " " " | 3909 | 3915 | | | |
| " " " | 8 BWPB | 3850 | 3856 | | | |
| " " " | 13 BWPB & scum | 3780 | 3794 | | | |

Describe in detail the manner in which the well was plugged, indicating where the mud fluid was placed and the method or methods used in introducing it into the hole. If cement or other plugs were used, state the character of same and depth placed, from feet to feet for each plug set.

Plugged back with crushed rock and 3 sax cement to 3760'.
Filled hole with mud. Squeezed in 25 sacks Aquagel mud
by Halliburton. Ran 8 5/8" cementing plug. Pumped in
100 sacks cement by Halliburton.

(If additional description is necessary, use BACK of this sheet)

Name of Plugging Contractor FORENS CASING PULLING CO.
Address GREAT BEND, KANSAS


STATE OF KANSAS COUNTY OF BARTON
S. S. MABRY (employee of owner) of the above-described

well, being first duly sworn on oath, says: That I have knowledge of the facts, statements, and matters herein contained and the log of the above-described well as filed and that the same are true and correct. So help me God.

(Signature) S. S. Mabry
BOX 744, GREAT BEND, KANSAS
(Address)

SUBSCRIBED AND SWORN TO before me this 1st day of OCTOBER, 19 52

My commission expires APRIL 11, 1956 Notary Public.

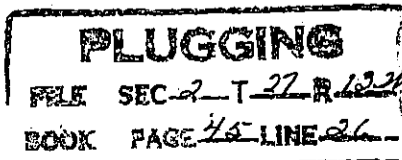

SHELL-C. F. BRIGGEMAN "C" #1
 NE NE SW Section 2-17S-13W
 Iuka-Carmi Field
 Pratt County, Kansas

CASING RECORD

8 5/8" cem 783 with 425 sax
 4 1/2" cem 4387 with 250 sax + 2% gel; perf. 3780-94

0 - 240 sand & shale
 300 shale, shells & redbed
 575 shale & shells
 745 redbed & shells
 770 redbed
 802 anhydrite
 1255 shale
 1580 shale & salt
 1680 shale & shells
 2600 lime & shale
 2631 lime
 2657 lime, shale streaks
 2671 lime
 2677 lime, shale streaks
 2683 lime
 2700 shale, limey
 2715 lime
 2728 shale
 2735 lime
 2741 shale
 2748 lime
 2755 shale
 2789 shale, sandy, limey
 2819 lime
 2833 shale & sandy shale
 2840 lime
 2860 shale & sand
 2870 shale, limey
 2887 " "
 2899 lime & limey shale
 2911 shale, trace sand
 2931 lime
 3083 lime & shale
 3097 lime
 3121 shale & sandy shale
 3141 lime
 3183 lime, sandy
 3218 shale & sandy shale
 Top Topeka 3218
 3471 lime
 3498 lime, trace chert
 3509 shale
 3547 lime
 3551 shale
 3566 lime
 Top Heebner 3566
 3571 shale
 3575 lime
 3581 shale
 Top Toronto 3581
 3591 lime
 3606 dolomite
 Top Douglas
 3664 shale & sandy shale

3671 lime w/ pyrite
 3729 shale, sandy, limey
 Top Brown Lime 3729
 3734 lime
 3752 shale & lime
 Top Lansing-Kansas
 City 3752.
 3771 lime
 3774 shale
 3815 lime
 3825 lime, trace chert
 3828 lime
 3838 lime, trace chert
 3846 lime
 3857 lime, shaley
 3860 lime
 3872 lime, trace chert
 3877 chert, limey
 3902 lime, limey chert
 3908 shale
 3918 lime
 3923 shale
 4023 lime
 4026 shale
 4055 lime
 4060 shale & lime
 4069 lime
 4073 shale
 4078 lime
 4083 shale
 4099 lime
 4106 shale & lime
 4127 lime, trace chert
 & shale.
 Top Marmaton 4127
 4139 chert, dolomitic
 4142 shale & limey chert
 4150 " " " "
 4181 chert, limey
 4195 shale, streaks chert,
 lime & shale
 4206 chert
 4212 shale & cherty lime
 4223 chert & cherty lime
 4228 shale, cherty lime.
 Top Viola 4228
 4262 chert, limey
 4276 shale, chert & limey
 cherty, siliceous lime
 Top Simpson 4276
 4278 shale, sand grains
 4292 sand, dolomitic, limey,
 shale streaks.

4294 dolomite, sandy
 4298 1/2 dolomite, sil. lime
 4300 dolomite, sandy
 4300 1/2 shale, dolomitic sand
 4302 1/2 shale with pyrite
 4303 1/2 shale, dolomitic sand streaks
 4306 1/2 dolomite, sandy
 4307 1/2 shale
 4318 sand, dolomitic
 4319 missing
 4386 shale
 Top Arbuckle
 4389 dolomite T.D.
 3818 PBTD

PLUGGING
 FILE SEC T R
 BOOK PAGE 45 LINE 20

RECEIVED
 STATE CORPORATION COMMISSION
 SEP 13 1952
 CONSERVATION DIVISION
 Wichita, Kansas