

STATE OF KANSAS
STATE CORPORATION COMMISSION

Form CP-4

Give All Information Completely
Make Required Affidavit
Mail or Deliver Report to:
Conservation Division
State Corporation Commission
211 No. Broadway
Wichita, Kansas

WELL PLUGGING RECORD

Pratt County, Sec. 1 Twp. 27 Rge. 13 (E) (W)

Location as "NE/CNW%SW%" or footage from lines SE NE NE

Lease Owner Terra Resources, Inc.

Lease Name Galbeck A Well No. 1

Office Address Drawer C, Great Bend, Ks. 67530

Character of Well (completed as Oil, Gas or Dry Hole) Water input

Date well completed 8-27 19 52

Application for plugging filed 4-24 19 74

Application for plugging approved 4-25 19 74


Plugging commenced 6-5 19 74

Plugging completed 6-12 19 74

Reason for abandonment of well or producing formation Junk in hole

If a producing well is abandoned, date of last production 19

Was permission obtained from the Conservation Division or its agents before plugging was commenced? Yes

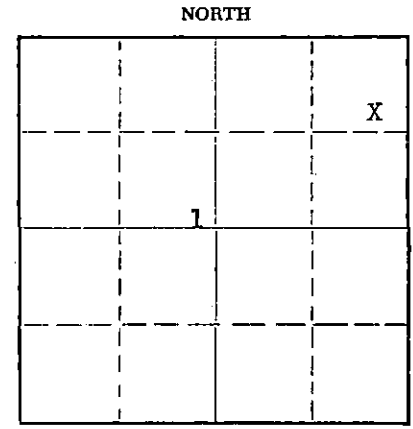

Locate well correctly on above Section Plat

Name of Conservation Agent who supervised plugging of this well G. R. Biberstein

Producing formation Simpson Ss Depth to top 4237 Bottom 4313 Total Depth of Well 4342 Feet

Show depth and thickness of all water, oil and gas formations.

OIL, GAS OR WATER RECORDS

CASING RECORD

FORMATION	CONTENT	FROM	TO	SIZE	PUT IN	PULLED OUT
				8 5/8	465	0
				5 1/2	4314	2144

Describe in detail the manner in which the well was plugged, indicating where the mud fluid was placed and the method or methods used in introducing it into the hole. If cement or other plugs were used, state the character of same and depth placed, from feet to feet for each plug set.

Dumped 21 sacks sand. Ran bailer in 5 1/2", stopped at 75'. Cleaned out scale and bridges to 3702'. Bridge solid at 3702'. Dumped 4 sacks cement with bailer. Top of cement at 3674'. Ran free point; pipe stuck at 2200'; 18% free at 2175'; 36% free at 2150'. Shot casing loose at 2150' and pulled freed casing. Pumped 10 sacks gelled water containing 3 sacks cottonseed hulls. Pumped 125 sacks cement (6% gel). Shut in pressure 200 psi. Checked top plug with wireline after 48 hours. Top of cement at 66' from surface. Filled casing to surface with 2 1/2 yds cement. WOC. Cut casing off below ground level and capped. Plugging complete.

RECEIVED
STATE CORPORATION COMMISSION
JUN 17 1974
6-17-74
CONSERVATION DIVISION
Wichita, Kansas

(If additional description is necessary, use BACK of this sheet)

Name of Plugging Contractor Kincaid Well Servicing Co.
Address Box 276, Ellinwood, Ks.

STATE OF Kansas, COUNTY OF Barton, ss.
C. E. McCartney (employee of owner) or (owner of well)

well, being first duly sworn on oath, says: That I have knowledge of the facts, statements, and matters herein contained and the log of the above-described well as filed and that the same are true and correct. So help me God.

(Signature) C. E. McCartney

Drawer C, Great Bend, Ks. 67530 (Address)

SUBSCRIBED AND SWORN to before me this 14th day of June 1974

My commission expires 12-7-76

LEROY DIETZ
STATE NOTARY PUBLIC
Barton County, Kansas
My Comm. Expires Dec. 7, 1976
Notary Public.

DRILLERS LOG

Calbeck "A" # 1

SE NE NE 1/27/13

Owner: Cooperative Refinery
Association

Pratt County

Contractor: Beardmore

Casing: 8 5/8 @ 465'
5 1/2 @ 4314'

Elevation: 1909 D.F.

RECEIVED
STATE CORPORATION COMMISSION
APR 25 1974
CONSERVATION DIVISION
Wichita, Kansas

Surface sand	0 - 80
Shale, red bed, shells	80 - 477
Shale and shells	477 - 1530
Shale and lime	1530 - 1990
Lime	1990 - 2245
Lime and shale	2245 - 2635
Shale	2635 - 2755
Shale and lime	2755 - 2860
Lime and shale	2860 - 2950
Lime	2950 - 3605
Sand	3605 - 3665
Lime and shale	3665 - 3720
Lime	3720 - 4090
Lime and Chert	4090 - 4120
Chert	4120 - 4159
Shale and chert	4159 - 4182
Chert	4182 - 4210
Shale	4210 - 4225
Colomite	4225 - 4234
Shale	4234 - 4242
Sand	4242 - 4313
R.T.D.	4313

I certify that this is the true and correct copy of the above log, to the best of my knowledge.

Morris D. Sullivan

Subscribed and sworn to before me this 8th day of November, 1960.

Betty S. Edman
Notary Public

My Commission Expires:
November 8, 1964