

API NUMBER 15097000660000
 LEASE NAME Roy Einsel
 WELL NUMBER 1

TYPE OR PRINT
 NOTICE: Fill out completely and return
 to Cons. Div. office within 30 days.

660 Ft. from S/N Line of Section (circle one)
660 Ft. from E/W Line of Section (circle one)

LEASE OPERATOR Herman Loeb
 ADDRESS Box 524
 CITY, STATE, ZIP Lawrenceville, IL 62439
 PHONE# (812) 853-3813 OPERATORS LICENSE NO. 3273
 Character of Well _____
 (Oil, Gas, D&A, SWD, Input, Water Supply Well)

SPOT LOCATION C - NW - NW
 SEC. 36 TWP. 27 S. RGE 19 11111 (W)
 COUNTY Kiowa
 Date Well Completed _____
 Date Plugging Commenced 4-15-1996
 Date Plugging Completed 4-17-1996

The plugging proposal was approved on _____ (date)
 by Dodge City, Ks. (KCC District Agent's Name)

Is ACO-1 filed? Yes If not, is well log attached? _____

Producing Formation(s) _____ Depth to Top _____ Bottom _____ T.D. 4888

Show depth and thickness of all water, oil and gas formations.

OIL, GAS OR WATER RECORDS

CASING RECORD

FORMATION	CONTENT	FROM	TO	SIZE	PUT IN	PULL OUT
		0	347'	8 5/8	347'	0
		0	4874'	4 1/2	4874'	3427'
						107 jts.

Described in detail the manner in which the well was plugged, indicating where the mud fluid was placed and the method or methods used in introducing it into the hole. If cement or other plugs were used, state the character of same and depth placed, from _____ feet to _____ feet each set.

4-15-96: Move in, rig up - pulled 174 nods and 142 jts. of tbg. Dumped 5x55 gallon bbls. of sand. Sand at 4150. Dump bailed 4x. of cement. Shot off csg. at 3427 - pulled 107 jts. { ~~Plugged with cement~~ }
4-17-96: Rigged down + moved off. { ~~Plugged with cement~~ }
 (If additional description is necessary, use BACK of this form.)

Name of Plugging Contractor Pratt Well Service, Inc.

License No. 5893

Address PO Box 847 Pratt, Ks.

NAME OF PARTY RESPONSIBLE FOR PLUGGING FEES: Herman Loeb

STATE OF Kansas COUNTY OF Pratt, ss.

Judy Berry (Employee of Pratt Well Service, Inc. of above-described well, being first

duly sworn on oath, says: That I have knowledge of the facts, statements, and matters herein contained and the log of the above-described well as filed that the same are true and correct, so help me God.

(Signature) Judy Berry

(Address) 90 PWS, Inc.

SUBSCRIBED AND SWORN TO before me this 30th day of April, 19 96

Kenneth W. Furgason
 Notary Public

My Commission Expires: 7-27-96



RECEIVED
 KANSAS CORPORATION COMMISSION
5-2-96
 MAY 02 1996


4-17-96: Ran 40jts tubing - total 1200' - Allied
ppd. 50 sx - Pulled 28jts to 750' - Allied
ppd. 50 sx - Pulled 11jts - Allied ppd 10
sx cement - pulled last jt. rigged down
+ moved off.

Lease: Roy Einsel
Well #: 1

Permit: API 15-097-000660000
Location: 36-27S-19W C NW NW
County: Kiowa
State: Kansas
Field: Einsel
Operator: Herman Loeb

Diagram: 04/04/1996
File KR: 9947
ID: 4888

Comp Date: 03/06/1962
File RT: 9949
PBD: 0

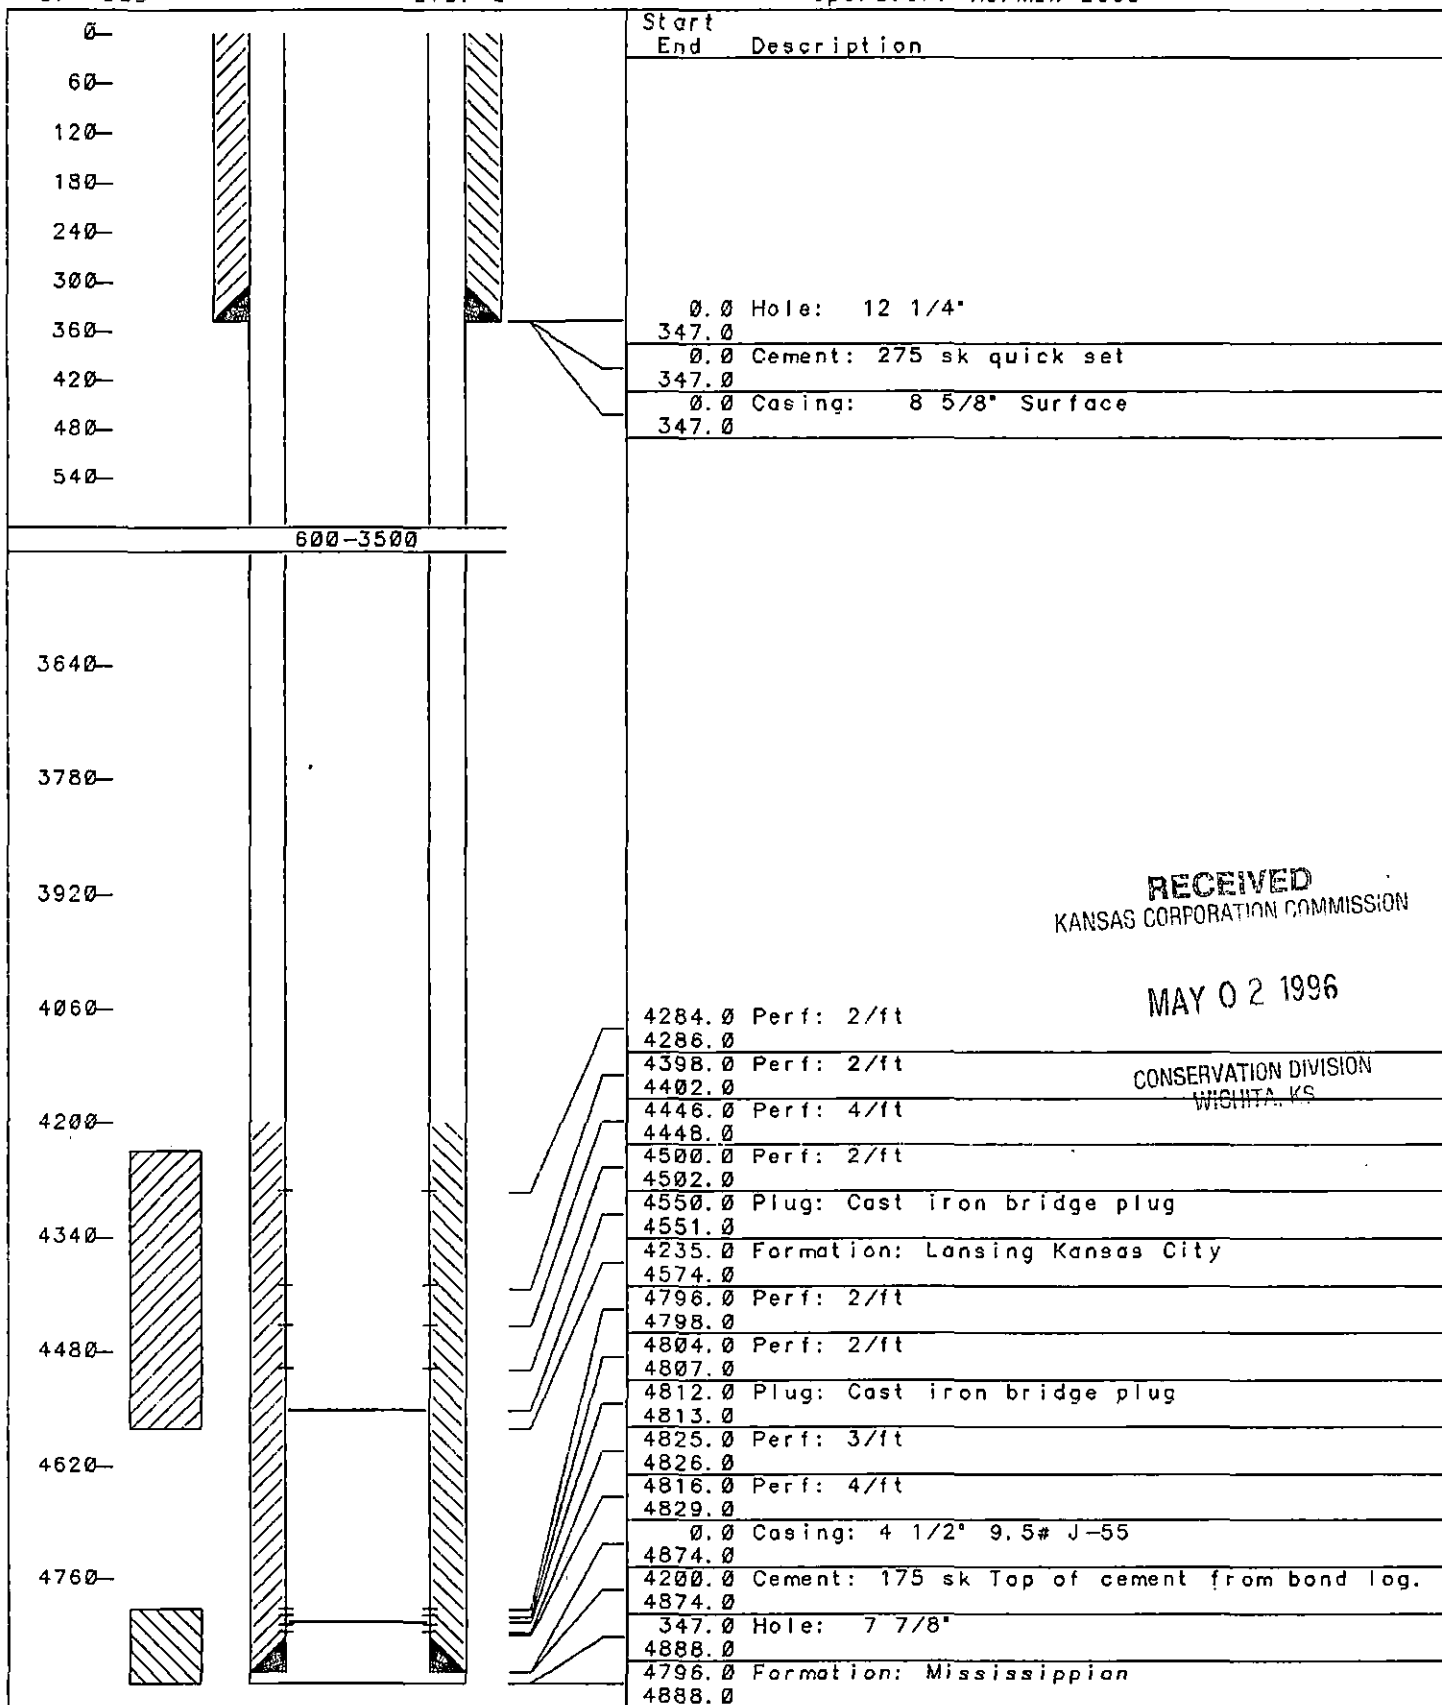

RECEIVED
KANSAS CORPORATION COMMISSION
MAY 02 1996
CONSERVATION DIVISION
WICHITA, KS