

STATE OF KANSAS  
STATE CORPORATION COMMISSION

WELL PLUGGING RECORD

Give All Information Completely  
Make Required Affidavit  
Mail or Deliver Report to  
Conservation Division  
State Corporation Comm.  
245 North Water  
Wichita, KS 67202

Kiowa County. Sec. 3 Twp. 27S Rge. 19W E/W  
Location as "NE/CNW $\frac{1}{4}$ SW $\frac{1}{4}$ " or footage from lines  
C SE/4 NE/4

Lease Owner Oil Properties Co., Inc.

Lease Name Little Well No. 1

Office Address Box 335 Andover, Kansas 67002

Character of Well (Completed as Oil, Gas or Dry Hole)  
dry hole

Date Well completed 2-3-78 19

Application for plugging filed 2-3-78 19

Application for plugging approved 19

Plugging commenced 2-3-78 19

Plugging completed 2-3-78 19

Reason for abandonment of well or producing formation


If a producing well is abandoned, date of last production 19

Was permission obtained from the Conservation Division or its agents before plugging was commenced? Yes

Name of Conservation Agent who supervised plugging of this well Wm. T. Owen

Producing formation Depth to top Bottom Total Depth of Well 4922'

Show depth and thickness of all water, oil and gas formations.

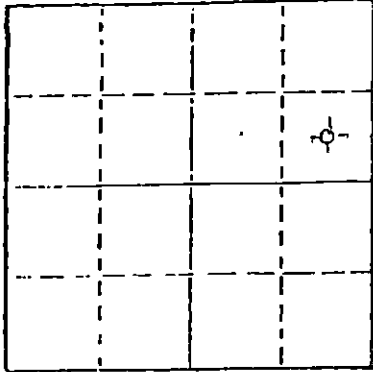

Locate well correctly on above Section Plat

OIL, GAS OR WATER RECORDS

CASING RECORD

FORMATION	CONTENT	FROM	TO	SIZE	PUT IN	PULLED OUT

Describe in detail the manner in which the well was plugged, indicating where the mud fluid was placed and the method or methods used in introducing it into the hold. If cement or other plugs were used, state the character of same and depth placed, from feet to feet for each plug-set.

- Spot 40 sks at 540'
- Spot 30 sks at 300'
- Spot 12 sks at 40'
- Spot 3 ska in rat hole

RECEIVED  
STATE CORPORATION COMMISSION  
6-19-78  
JUN 19 1978  
CONSERVATION DIVISION  
Wichita, Kansas

(If additional description is necessary, use BACK of this sheet)

Name of Plugging Contractor Gabbert-Jones, Inc. & Allied Cementing

STATE OF Kansas COUNTY OF Butler, ss.  
David S. Jackman, III (employee of owner) or (owner or operator)  
of the above-described well, being first duly sworn on oath, says: That I have knowledge of the facts, statements, and matters herein contained and the log of the above-described well as filed and that the same are true and correct. So help me God.

(Signature) David S. Jackman III  
P.O. Box 335 Andover, Kansas 67002  
(Address)

SUBSCRIBED AND SWORN TO before me this 6th day of June, 1978

M. L. Traugott  
M. L. Traugott Notary Public.

My commission expires 30 Dec. 1978

M. L. TRAUGOTT  
STATE NOTARY PUBLIC  
SUMNER COUNTY, KANSAS  
MY COMM. EXP. 12-30-78

GABBERT-JONES, INC.  
 WICHITA, KANSAS  
 DRILLERS' WELL LOG

Little #1  
 C SE NE Sec 3-27S-19W  
 Kiowa County Kansas

Commenced: 1-20-78

Completed: 2-3-78

OPERATOR: OIL PROPERTIES CO., INC.

Depth		Formation	Remarks
From	to		
0	352	Sand-Top Soil	Ran 8 jts of 28# 8 5/8" csg
352	1252	Shale-Redbed	set @ 348' Cemented
1252	1284	Anhy	225 sks Common 2% Gel
1284	1660	Shale	3% CC PD @ 5:00 a.m.
1660	4300	Lime-Shale	1-21-78
4300	4922	Lime	
	4922 - TD		DRY & ABANDONED

STATE OF KANSAS )  
 ) SS  
 COUNTY OF SEDGWICK)

I, the undersigned, being duly sworn on oath, state that the above  
 Drillers' Well Log is true and correct to the best of my knowledge and belief and  
 according to the records of this office.

GABBERT-JONES, INC.

*James S. Sutton II*  
 JAMES S. SUTTON II

Subscribed and sworn to before me this 9th day of February, 1978:

*Elizabeth J. Edwards*  
 ELIZABETH J. EDWARDS-NOTARY PUBLIC

My Commission expires February 6, 1979.

RECEIVED

MAR 23 1978

CONSERVATION DIVISION  
 Wichita, Kansas

