


STATE-OF KANSAS
STATE-CORPORATION COMMISSION

WELL PLUGGING RECORD

Give All Information Completely
Make Required Affidavit
Mail or Deliver Report to:
Conservation Division
State Corporation Commission
211 No. Broadway
Wichita, Kansas

Kiowa County, Sec. 1 Twp. 27S Rge. (E) 19 (W)
Location as "NE/CNW/SW" or footage from lines C SW/4 NW/4
Lease Owner Braden Drilling, Inc.
Lease Name L. Emil Fisher Well No. 1
Office Address 1206 Union National Bldg. Wichita, Kansas
Character of Well (completed as Oil, Gas or Dry Hole) Dry hole
Date well completed December 26 1961
Application for plugging filed December 26 1961
Application for plugging approved December 26 1961
Plugging commenced December 26 1961
Plugging completed December 26 1961
Reason for abandonment of well or producing formation _____

NORTH

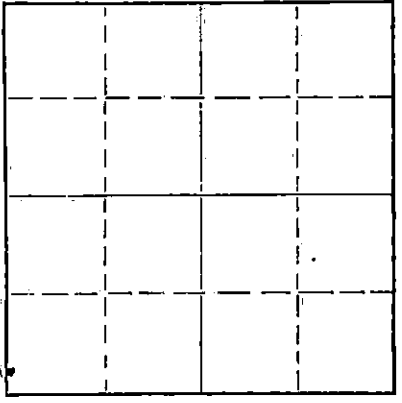

Locate well correctly on above
Section Flat

If a producing well is abandoned, date of last production _____ 19____
Was permission obtained from the Conservation Division or its agents before plugging was commenced? yes

Name of Conservation Agent who supervised plugging of this well Fred W. Hampel
Producing formation _____ Depth to top _____ Bottom _____ Total Depth of Well 4865 Feet
Show depth and thickness of all water, oil and gas formations.

OIL, GAS OR WATER RECORDS CASING RECORD

FORMATION	CONTENT	FROM	TO	SIZE	PUT IN	PULLED OUT
		0	673	8 5/8	673	none

Describe in detail the manner in which the well was plugged, indicating where the mud fluid was placed and the method or methods used in introducing it into the hole. If cement or other plugs were used, state the character of same and depth placed, from _____ feet to _____ feet for each plug set.

Set plug at 300' and cemented with 20 sacks cement. Filled with heavy mud. Plug at 40' and cemented with 10 sacks. Filled rat hole with 2 sacks cement.

RECEIVED
STATE CORPORATION COMMISSION
1-5-62
JAN 5 1962
CONSERVATION DIVISION
Wichita, Kansas

(If additional description is necessary, use BACK of this sheet)
Name of Plugging Contractor Braden Drilling, Inc.
Address 1206 Union National Bldg., Wichita, Kansas

STATE OF Kansas COUNTY OF Sedgwick, ss.
F. M. Callaway (employee of owner) or (owner or operator) of the above-described well, being first duly sworn on oath, says: That I have knowledge of the facts, statements, and matters herein contained and the log of the above-described well as filed and that the same are true and correct. So help me God.

(Signature) [Signature]
1206 Union National Bldg., Wichita, Kansas
(Address)

SUBSCRIBED AND SWORN TO before me this 29 day of December, 1961

My commission expires March 21, 1962
[Signature] Notary Public.

