


STATE OF KANSAS
STATE CORPORATION COMMISSION
CONSERVATION DIVISION
P. O. BOX 17027
WICHITA, KANSAS 67217

FORM CP-4

WELL PLUGGING RECORD

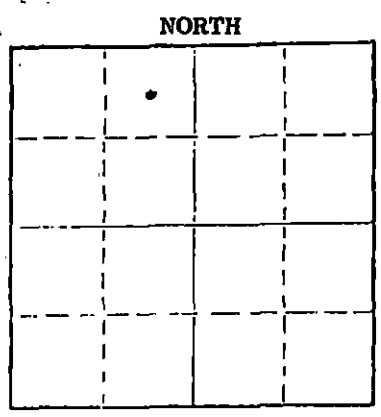

Locate well correctly on above Section Plat

Kiowa County. Sec. 10 Twp. 27 Rge. 19 (E) (W)
Location as "NE/CNW/SW" or footage from lines App. C NE NW
Lease Owner Petroleum, Inc.
Lease Name Kerr Well No. 1
Office Address Route 2, Great Bend, Kansas 67530
Character of Well (completed as Oil, Gas or Dry Hole) oil
Date well completed 19
Application for plugging filed Dec. 19 75
Application for plugging approved 19
Plugging commenced Dec. 17 19 75
Plugging completed Jan. 2 19 76
Reason for abandonment of well or producing formation depleted

If a producing well is abandoned, date of last production 19
Was permission obtained from the Conservation Division or its agents before plugging was commenced? YES

Name of Conservation Agent who supervised plugging of this well G. R. Biberstein
Producing formation _____ Depth to top _____ Bottom _____ Total Depth of Well 4938 feet
Show depth and thickness of all water, oil and gas formations.

OIL, GAS OR WATER RECORDS				CASING RECORD		
FORMATION	CONTENT	FROM	TO	SIZE	PUT IN	PULLED OUT
			333'	8 5/8"	333'	none
			4936'	5 1/2"	4936'	2289.87

Describe in detail the manner in which the well was plugged, indicating where the mud fluid was placed and the method or methods used in introducing it into the hole. If cement or other plugs were used, state the character of same and depth placed, from _____ feet to _____ feet for each plug set.

Pumped 50 sacks of cement on bottom. Spot plug at 4150'.

Pumped in 2 sacks of hulls, 10 sacks of gel and 100 sacks of cement.

RECEIVED
STATE CORPORATION COMMISSION
1-12-76
JAN 12 1976

Name of Plugging Contractor PIPE PULLERS, INC. (If additional description is necessary, use BACK of this sheet)
Address Box 128, Ellinwood, Kansas 67526
CONSERVATION DIVISION
Wichita, Kansas

STATE OF KANSAS COUNTY OF BARTON ss.
Evelyn Roth (employee of owner) or (owner or operator) of the above-described

well, being first duly sworn on oath, says: That I have knowledge of the facts, statements, and matters herein contained and the log of the above-described well as filed and that the same are true and correct. So help me God.

(Signature) Evelyn Roth
Ellinwood, Kansas (Address)

Subscribed AND SWORN to before me this 8th day of January, 1976

My commission expires
JENNY KASSELMAN
NOTARY PUBLIC
BARTON COUNTY, KANSAS
MY COMM. EXP. JULY 16, 1978

Jenny Kasselmann
Notary Public.

WELL LOG

COMPANY **Petroleum, Inc.**
 FARM **Zerr** NO. **1**
 TOTAL DEPTH **4938'**
 COMM. **6-29-70** COMP. **7-13-70**
 CONTRACTOR **Garvey Drilling Company**

SEC. **10** T. **27S** R. **19W**

LOC. **C NE NW**

COUNTY **Kiowa, Kansas**

CASING

8 5/8" @ 333' w/250sx
5 1/2" @ 4936' w/210sx

ELEVATION **2267' ±**

PRODUCTION

FIGURES INDICATE BOTTOM OF FORMATIONS

- 169' Sand
- 333' Shale
- 500' Shell, Shale, & Clay
- 1260' Shale & Red Bed
- 1277' Anhydrite
- 1318' Shale & Shells
- 2315' Shale
- 2495' Lime & Shale
- 2560' Shale & Lime
- 2690' Lime & Shale
- 2940' Shale & Lime
- 3050' Lime & Shale
- 3320' Shale & Lime
- 3420' Lime & Shale
- 3683' Lime & Shale w/sand streaks
- 3767' Lime & Shale
- 3815' Shale & Lime
- 4065' Lime & Shale
- 4197' Shale & Lime
- 4235' Lime
- 4375' Lime & Shale
- 4629' Lime
- 4805' Lime & Chert
- 4873' Mississippi
- 4888' Lime
- 4936' Shale & Sand
- 4938' RTD

RECEIVED
STATE CORPORATION COMMISSION


JAN 14 1976

CONSERVATION DIVISION
Wichita, Kansas

State of Kansas }
 County of Barton } SS

I, Charlene Marker of Garvey Drilling Company

upon oath state the above and foregoing is a true and correct copy of the log of the Zerr No. 1 well.

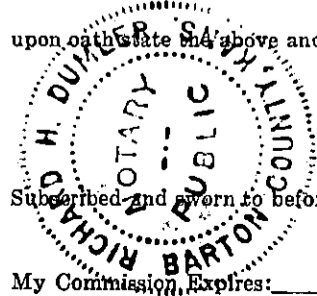

Charlene Marker

Subscribed and sworn to before me this 15th day of July 19 70

My Commission Expires: May 28, 1973

Richard H. Dumber
NOTARY PUBLIC