


STATE OF KANSAS
STATE CORPORATION COMMISSION

Give All Information Completely
Make Required Affidavit
Mail or Deliver Report to
Conservation Division
State Corporation Commission
245 North Water
Wichita, KS 67202

FORM CP-4

WELL PLUGGING RECORD

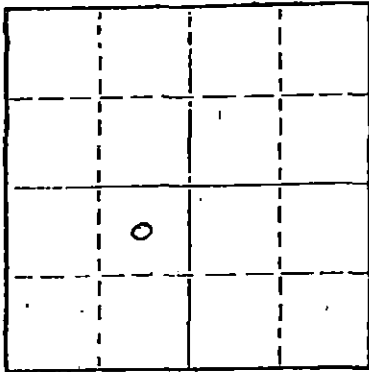

Locate well correctly on above
Section Plot

Kiowa County, Sec. 10 Twp. 27 Rge. 19 (E) (W)
Location as "NE/CNW/SE/SW" or footage from lines C NE SW
Lease Owner Pickerell Drilling Company
Lease Name Davis J#1 Well No.
Office Address Great Bend, Kansas 67530
Character of Well (completed as Oil, Gas or Dry Hole)
Date well completed Abd. after swab test 2-21-76 19
Application for plugging filed 19
Application for plugging approved 19
Plugging commenced 2/26/76 19
Plugging completed 3/6/76 19
Reason for abandonment of well or producing formation depleted.

2- If a producing well is abandoned, date of last production Never Produced 19
Was permission obtained from the Conservation Division or its agents before plugging was commenced? YES

Name of Conservation Agent who supervised plugging of this well Biberstein
3 Producing formation Kansas City Depth to top 4363 Bottom 4369 Total Depth of Well 4945 Feet
Show depth and thickness of all water, oil and gas formations.

OIL, GAS OR WATER RECORDS

CASING RECORD

FORMATION	CONTENT	FROM	TO	SIZE	PUT IN	PULLED OUT
				8-5/8	310	none
				4 1/2"	4445	3570'
Kansas City	Water & Oil	4363	4369	(Abandoned after swab test)		

Describe in detail the manner in which the well was plugged, indicating where the mud fluid was placed and the method or methods used in introducing it into the hole. If cement or other plugs were used, state the character of same and depth placed, from _____ feet to _____ feet for each plug set.

2 Sanded to 4350' and rigged up. Shot pipe at 3915', 3795', 3628', spotted oil. Shot pipe at 3554', pulled 88 joints of 4 1/2" casing. Tried to bail hole, had 4 yards ready mix out but couldn't get hole bailed down. (Allied) pumped 2 sacks hulls, 10 sacks gel and 100 sacks 50-50 port cement.

PLUGGING COMPLETE.

3-17-76
CONSERVATION DIVISION
Wichita, Kansas

(If additional description is necessary, use BACK of this sheet)
Name of Plugging Contractor KELSO CASING PULLING
Address CHASE, KANSAS

STATE OF KANSAS COUNTY OF RICE, ss.
NOEL J. KNIGHT (employee of owner) or (owner or operator) of the above-described well, being first duly sworn on oath, says: That I have knowledge of the facts, statements, and matters herein contained and the log of the above-described well as filed and that the same are true and correct. So help me God.

(Signature) *R. Donald Fisher*
CHASE, KANSAS

Subscribed and sworn to before me this 10th day of March, 1976

Margaret Melgher
Notary Public

My commission expires

