

15.009.20529.00.00

STATE OF KANSAS
STATE CORPORATION COMMISSION

Form CP-4

Give All Information Completely
Make Required Affidavit
Mail or Deliver Report to:
Conservation Division
State Corporation Commission
212 No. Market
Wichita, Kansas

WELL PLUGGING RECORD

Barton County. Sec. 36 Twp. 18 Rge. 15 (E) W(W)

Location as "NE/CNWKSWK" or footage from lines NW NE NE

Lease Owner Icer Addis

Lease Name Howell Well No. 3

Office Address Box 519 - Great Bend, Kansas

Character of Well (completed as Oil, Gas or Dry Hole) Dry Hole

Date well completed Sept. 18, 1970 19

Application for plugging filed " " 19

Application for plugging approved " " 19


Plugging commenced Sept. 18, 1970 19

Plugging completed " " " " 19

Reason for abandonment of well or producing formation _____

If a producing well is abandoned, date of last production _____ 19

Was permission obtained from the Conservation Division or its agents before plugging was commenced? yes

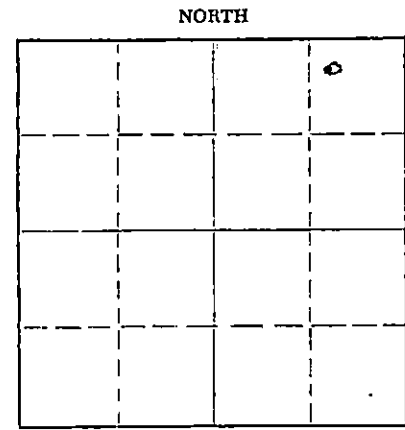

Locate well correctly on above Section Plat

Name of Conservation Agent who supervised plugging of this well Don Truan

Producing formation _____ Depth to top _____ Bottom _____ Total Depth of Well 3551 Feet

Show depth and thickness of all water, oil and gas formations.

OIL, GAS OR WATER RECORDS

CASING RECORD

FORMATION	CONTENT	FROM	TO	SIZE	PUT IN	PULLED OUT

Describe in detail the manner in which the well was plugged, indicating where the mud fluid was placed and the method or methods used in introducing it into the hole. If cement or other plugs were used, state the character of same and depth placed, from _____ feet to _____ feet for each plug set.

Heavy mud up to 400' - Plug & 25 sacks cement
come up hole to 40' - plug - 1/2 sack & hulls & 10 sacks cement
5 saks cement in rat hole

RECEIVED
STATE CORPORATION COMMISSION
SEP 22 1970
CONSERVATION DIVISION
Wichita, Kansas

(If additional description is necessary, use BACK of this sheet)

Name of Plugging Contractor _____

Address _____

STATE OF Kansas, COUNTY OF Barton, ss.

Larry Curtis (employee of owner) or (~~owner~~) of the above-described

well, being first duly sworn on oath, says: That I have knowledge of the facts, statements, and matters herein contained and the log of the above-described well as filed and that the same are true and correct. So help me God,

(Signature) Larry Curtis

Box 823 - Great Bend, Kansas
(Address)

SUBSCRIBED AND SWORN to before me this 21st day of September, 1970

Alcey M. Hague
Notary Public.

My commission expires 4-11-74

dr

W E L L L O G

DATE COMMENCED: September 10, 1970
 DATE COMPLETED: September 18, 1970

Loc. Addis
 HOWELL #3
 NW/4 NE/4 NE/4
 Section 36-T18S-R15W
 Barton County, Kansas

0	-	100'	Sand & Clay
100	-	377'	Shale w/sd & hd. sd. strks.
377	-	535'	Sand & Shale
535	-	899'	Red Bed
899	-	924'	Anhydrite
924	-	1765'	Shale & Shells
1765	-	2115'	Shale & Lm.
2115	-	2245'	Line & Shale
2245	-	2510'	Shale
2510	-	2905'	Line & Shale
2905	-	3146'	Line
3146	-	3150'	Shale
3150	-	3161'	Line & Shale
3161	-	3177'	Line
3177	-	3223'	Shale
3223	-	3231'	Line & Shale
3231	-	3454'	Line
3454	-	3485'	Shale
3485	-	3551'	Conglomerate
		3551'	RTD

ELEVATION: 1906 K.B.

FORMATIONS	
ANHYDRITE	899
TOPEKA	2905
HEEDNER	3146
TORONTO	3161
DOUGLAS	3177
BROWN LIMB	3223
KANSAS CITY	3231
BASE K.C.	3454
CONGLOMERATE	3485
RTD	3551

SURFACE PIPE: Set 916'
 of new 8-5/8", 20# casing
 with 400 sacks cement.

RECEIVED
 STATE CORPORATION COMMISSION
 SEP 22 1970
 CONSERVATION DIVISION
 Wichita, Kansas

A F F I D A V I T

STATE OF KANSAS
 COUNTY OF BARTON ss.

Larry Curtis of lawful age, does swear and state that the facts and statements herein contained are true and correct to the best of his knowledge.

Larry Curtis

Subscribed and sworn to before me this 21 day of September, 1970.

My Comm. Expires: _____

Dorothy M. Hague
 Notary Public