

FOR KCC USE:

FORM C-1 7/79

FORM MUST BE TYPE

FORM MUST BE SIGNED

ALL BLANKS MUST BE FILLED

EFFECTIVE DATE: 7-7-93

State of Kansas

NOTICE OF INTENTION TO DRILL

DISTRICT # 2

Must be approved by the K.C.C. five (5) days prior to commencing well

Expected Spud Date 07 04 93 Sec 33 Twp 25 S, Rg 8 East West

OPERATOR: License # 5316 Name: Falcon Exploration, Inc. Address: 155 N. Market, Suite 1010 City/State/Zip: Wichita, KS 67202 Contact Person: Jim Thatcher Phone: (316) 265-3351

620 feet from South / North line of Section 2780 feet from East / West line of Section IS SECTION X REGULAR IRREGULAR?

(NOTE: Locate well on the Section Plat on Reverse Side) County: Reno Lease Name: Trembley Well #: 1 Field Name: unknown

CONTRACTOR: License #: 5420 Name: White & Ellis Drilling

Is this a Prorated/Spec'd Field? yes X no Target Formation(s): Mississippi Nearest lease or unit boundary: 400

Well Drilled For: Well Class: Type Equipment: X Oil Enh Rec Infield X Mud Rotary Gas Storage X Pool Ext Air Rotary OWD Disposal Wildest Cable Seismic: # of Holes Other

Ground Surface Elevation: feet MSL Water well within one-quarter mile: X yes no Public water supply well within one mile: yes X no Depth to bottom of fresh water: 48.45

If OWD: old well information as follows: Operator: Well Name: Comp. Date: Old Total Depth

Depth to bottom of usable water: 80 Surface Pipe by Alternate: X 1 2 Length of Surface Pipe Planned to be set: (360) 200

Directional, Deviated or Horizontal wellbore? yes X no If yes, true vertical depth: Bottom Hole Location:

Length of Conductor pipe required: 0 Projected Total Depth: 4000 Formation at Total Depth: Mississippi Water Source for Drilling Operations: well farm pond X other

AFFIDAVIT

The undersigned hereby affirms that the drilling, completion and eventual plugging of this well will comply with K.S.A. 55-101, et. seq. It is agreed that the following minimum requirements will be met:

- 1. Notify the appropriate district office prior to spudding of well; 2. A copy of the approved notice of intent to drill shall be posted on each drilling rig; 3. The minimum amount of surface pipe as specified below shall be set by circulating cement to the top; in all cases surface pipe shall be set through all unconsolidated materials plus a minimum of 20 feet into the underlying formation; 4. If the well is dry hole, an agreement between the operator and the district office on plug length and placement is necessary prior to plugging; 5. The appropriate district office will be notified before well is either plugged or production casing is cemented in; 6. IF AN ALTERNATE II COMPLETION, PRODUCTION PIPE SHALL BE CEMENTED FROM BELOW ANY USABLE WATER TO SURFACE WITHIN 120 DAYS OF SPUD DATE. IN ALL CASES, NOTIFY DISTRICT OFFICE PRIOR TO ANY CEMENTING.

I hereby certify that the statements made herein are true and to the best of my knowledge and belief.

Date: 6/29/93 Signature of Operator or Agent: Jim Thatcher Title: AGENT

FOR KCC USE: API # 15- 155-21269-0000 Conductor pipe required None feet Minimum surface pipe required 200 feet per Alt. (1) Approved by: C.B. 7-2-93 This authorization expires: 1-2-94 (This authorization void if drilling not started within 6 months of effective date.) Spud date: Agent:

RECEIVED STATE CORPORATION COMMISSION JUN 30 1993 CONSERVATION DIVISION Wichita, Kansas

REMEMBER TO:

- File Drill Plat Application (form CDP-1) with Intent to Drill; - File Completion Form ACD-1 within 120 days of spud date; - File acreage attribution plat according to field preparation orders; - Notify appropriate district office 48 hours prior to workover or re-entry; - Submit plugging report (CP-4) after plugging is completed; - Obtain written approval before disposing or injecting salt water.

Mail to: Conservation Division, 200 Colorado Derby Building, 202 W. First St., Wichita, Kansas 67202-1286.

IN ALL CASES PLOT THE INTENDED WELL ON THE PLAT BELOW

PLAT OF ACREAGE ATTRIBUTABLE TO A WELL IN A PRORATED OR SPACED FIELD

If the intended well is in a prorated or spaced field, please fully complete this side of the form. If the intended well is in a prorated or spaced field complete the plat below showing that the well will be properly located in relationship to other wells producing from the common source of supply. Please show all the wells within 1 mile of the boundaries of the proposed acreage attribution unit for gas wells and within 1/2 mile of the boundaries of the proposed acreage attribution unit for oil wells.

API NO. 15- \_\_\_\_\_  
 OPERATOR Falcon Exploration Inc.  
 LEASE Trembley  
 WELL NUMBER 1  
 FIELD \_\_\_\_\_

LOCATION OF WELL: COUNTY Reno  
660 feet from south/north line of section  
2130 feet from east/west line of section  
 SECTION 33 TWP 2S RG 8W



NUMBER OF ACRES ATTRIBUTABLE TO WELL \_\_\_\_\_  
 QTR/QTR/QTR OF ACREAGE \_\_\_\_\_

IS SECTION X REGULAR or IRREGULAR  
IF SECTION IS IRREGULAR, LOCATE WELL FROM NEAREST CORNER BOUNDARY.

Section corner used: NE NW SE SW

PLAT

(Show location of the well and shade attributable acreage for prorated or spaced wells.)  
 (Show footage to the nearest lease or unit boundary line.)

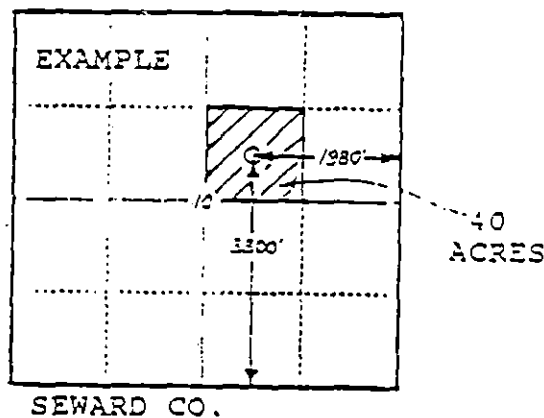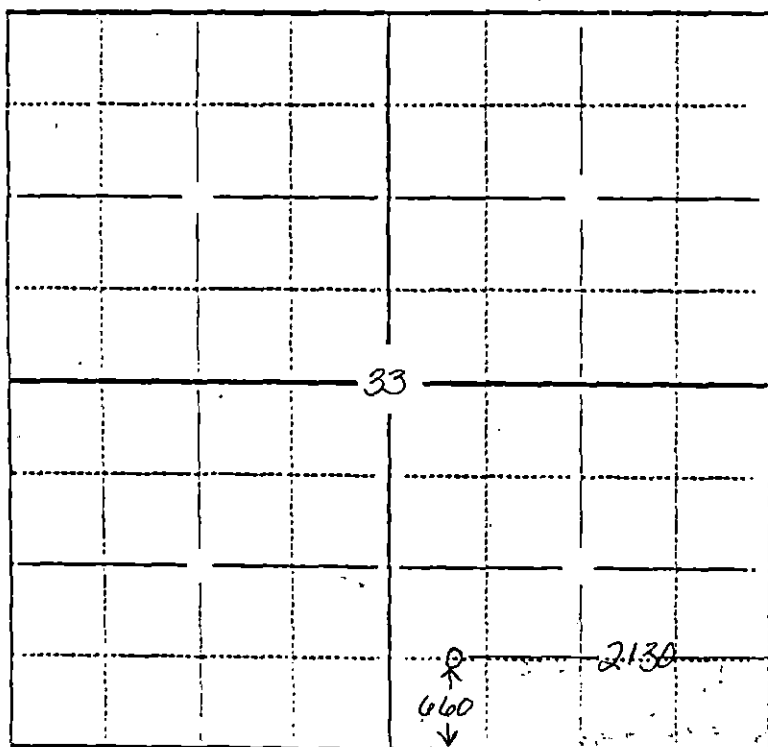

In plotting the proposed location of the well, you must show:

- 1) The manner in which you are using the depicted plat by identifying section lines, i.e. 1 section, 1 section with 8 surrounding sections, 4 sections, etc.;
- 2) the distance of the proposed drilling location from the section's south/north and east/west lines; and
- 3) the distance to the nearest lease or unit boundary line.