


STATE OF KANSAS
STATE CORPORATION COMMISSION

Form CP-4

Give All Information Completely
Make Required Affidavit
Mail or Deliver Report to:
Conservation Division
State Corporation Commission
212 No. Market
Wichita, Kansas 67202

NORTH

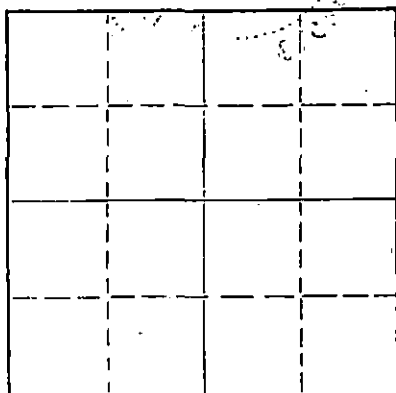

Locate well correctly on above
Section Flat

WELL PLUGGING RECORD

Pratt County, Sec. 30 Twp. 27 Rge. 13 (E) (W)
Location as "NE/CNW/SW" or footage from lines SE SE NW
Lease Owner Maurice L. Brown
Lease Name Fitzsimmons #1 Well No.
Office Address Kansas City, Missouri 64104
Character of Well (completed as Oil, Gas or Dry Hole)
Date well completed 19
Application for plugging filed 19
Application for plugging approved 19
Plugging commenced 9/4/70 19
Plugging completed 9/18/70 19
Reason for abandonment of well or producing formation depleted.
If a producing well is abandoned, date of last production 19
Was permission obtained from the Conservation Division or its agents before plugging was commenced? yes

Name of Conservation Agent who supervised plugging of this well Biberstein
Producing formation Depth to top Bottom Total Depth of Well 4445 Feet
Show depth and thickness of all water, oil and gas formations.

OIL, GAS OR WATER RECORDS

CASING RECORD

FORMATION	CONTENT	FROM	TO	SIZE	PUT IN	PULLED OUT
				8-5/8	379	none
				5 1/2"	4445'	3208'

Describe in detail the manner in which the well was plugged, indicating where the mud fluid was placed and the method or methods used in introducing it into the hole. If cement or other plugs were used, state the character of same and depth placed, from feet to feet for each plug set.

Checked hole to 4408', ran sand to 4000' and dumped 5 sacks of cement.
Loaded hole, shot pipe at 3586', spotted 60 barrels oil, shot pipe at
3495', 3400', 3300', 3200', worked pipe loose and pulled 97 joints.
Set rock bridge at 365', dumped 5 sacks of cement. Bailed fluid down to
top of plug, dumped 5 yards ready mix.

PLUGGING COMPLETE.

RECEIVED
STATE CORPORATION COMMISSION
SEP 28 1970
CONSERVATION DIVISION
Wichita, Kansas

(If additional description is necessary, use BACK of this sheet)
Name of Plugging Contractor KNIGHT CASING PULLING CO., INC.
Address CHASE, KANSAS

STATE OF KANSAS COUNTY OF RICE
NOEL J. KNIGHT (employee of owner) or (owner or operator) of the above-described
well, being first duly sworn on oath, says: That I have knowledge of the facts, statements, and matters herein contained and the log of the
above-described well, and that the same are true and correct. So help me God.

(Signature)

CHASE, KANSAS

(Address)

SUBSCRIBED AND SWORN to before me this 21st day of September, 1970

My commission expires

4/15/71

Notary Public.

WICHITA SEP 25 1970

WELL LOG BUREAU—KANSAS GEOLOGICAL SOCIETY
508 East Murdock, Wichita, Kansas

COPY


Company W. J. COPPINGER et
Farm Fitzsimmons No

C. 30 T. 27 R. 13W
SE SE NW

Total Depth. 4561
Comm. 2-53 Comp. 1-2
Start of Test
Contractor.
Issued. 3-20-53

County Pratt

KANSAS

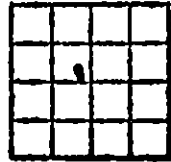

CASING:

8 5/8" 379' cem w/250 sx
5 1/2" 4445' cem w/125 sx

Elevation. 1925 D.F.

Production. BHB 1052 bbls & no wtr

res indicate Bottom of Formations.

clay, sand	40
sand	60
shale	110
sand, shale	205
red bed	380
red bed, shale	800
red bed, blue shale	815
anhydrite	850
red bed, shale	1000
shale, shells	1825
lime, shale	2325
lime	2430
lime, shale	2590
lime	2605
shale	2670
lime, shale	3060
shale	3115
shale, lime	3410
sand, lime	3475
lime	3645
lime, shale	3816
lime	4156
lime, shale	4206
lime cherty	4270
shale, cherty lime	4299
shale	4320
lime cherty	4407
sand	4415
sand, shale	4449
shale, cherty lime	4485
lime, shale	4522
lime	4561

T. D. RTD

Tops:
Anhydrite 815
Heebner 3664
Bronw "Lime" 3815
Lansing KC 3830
Mississippian 4262
Kinderhook 4291
Viola 4320
Simpson sandstone 4406
Arbuckle 4505

RECEIVED
STATE CORPORATION COMMISSION
AUG 19 1970
CONSERVATION DIVISION
Wichita, Kansas