


Give All Information Completely
Make Required Affidavit
Mail or Deliver Report to:
Conservation Division
State Corporation Commission
211 No. Broadway
Wichita, Kansas

WELL PLUGGING RECORD

NORTH

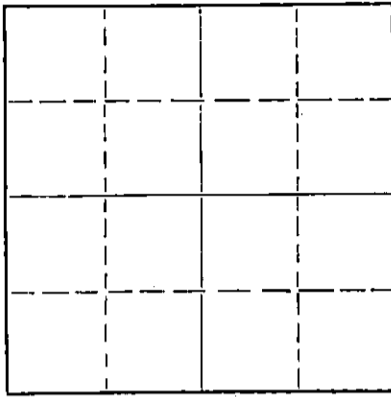

Locate well correctly on above
Section Plat

Pratt County, Sec. 25 Twp. 27S Rge. 13 ~~W~~ (W)

Location as "NE/CNW/SW" or footage from lines C SW SE
Lease Owner A. Scott Ritchie & James B. Devlin
Lease Name Bergner Well No. 1
Office Address 301 Central Building, Wichita 2, Kansas
Character of Well (completed as Oil, Gas or Dry Hole) Dry Hole
Date well completed April 23, 1962
Application for plugging filed April 23, 1962
Application for plugging approved April 23, 1962
Plugging commenced April 23, 1962
Plugging completed April 23, 1962
Reason for abandonment of well or producing formation Dry Hole

If a producing well is abandoned, date of last production 19
Was permission obtained from the Conservation Division or its agents before plugging was commenced? Yes

Name of Conservation Agent who supervised plugging of this well _____
Producing formation _____ Depth to top _____ Bottom _____ Total Depth of Well 4,360 Feet
Show depth and thickness of all water, oil and gas formations.

OIL, GAS OR WATER RECORDS

CASING RECORD

FORMATION	CONTENT	FROM	TO	SIZE	PUT IN	PULLED OUT
				8 5/8"	363'	None

Describe in detail the manner in which the well was plugged, indicating where the mud fluid was placed and the method or methods used in introducing it into the hole. If cement or other plugs were used, state the character of same and depth placed, from _____ feet to _____ feet for each plug set.

Filled hole with heavy rotary mud from 4,360 feet (R.T.D.) to 300 feet. Set bottom plug at 300 feet and cemented with 1/2 sack hulls and 20 sacks cement. Filled hole with heavy rotary mud to 40 feet. Set top plug at 40 feet and cemented with 1/2 sack hulls and 40 sacks cement, filling hole to 4 feet below ground level.

RECEIVED
STATE CORPORATION COMMISSION

MAY 2 1962 5-2-62

CONSERVATION DIVISION
Wichita, Kansas

(If additional description is necessary, use BACK of this sheet)

Name of Plugging Contractor H-30, Inc.
Address 709 Petroleum Building, Wichita 2, Kansas

STATE OF Kansas, COUNTY OF Sedgwick, ss. contractor
Priscilla M. Ismert (employee of ~~owner of above-described well~~) of the above-described well, being first duly sworn on oath, says: That I have knowledge of the facts, statements, and matters herein contained and the log of the above-described well as filed and that the same are true and correct. So help me God.

(Signature) Priscilla M. Ismert
709 Petroleum Building, Wichita 2, Kansas
(Address)

SUBSCRIBED AND SWORN TO before me this 30th day of April, 19 62

My commission expires December 3, 1964

Geraldine Hays
Notary Public.



KANSAS GEOLOGICAL SOCIETY
 KANSAS WELL LOG BUREAU - KANSAS WELL SAMPLE BUREAU
 KANSAS GEOLOGICAL SOCIETY BUILDING
 508 EAST MURDOCK - WICHITA, KANSAS


COMPANY A. Scott Ritchie & James B. Devlin

SEC 25 T. 27S R. 13W
 LOC. C/SW SE

FARM Bergner No. 1

TOTAL DEPTH 4,360'
 COMM. 4-9-62 COMP. 4-23-62
 SHOT OR TREATED
 CONTRACTOR H-30, Inc.
 ISSUED

COUNTY Pratt
 KANSAS

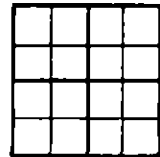

CASING
 20 10
 15 8 5/8" 363' cem. w/250 SX.
 12 6
 13 5

ELEVATION 1893 KB

PRODUCTION D & A

FIGURES INDICATE BOTTOM OF FORMATIONS

Sand, Shale & Shells	250
Shale & Lime shells	363
Red Bed, Shale & Shells	684
Anhydrite	744
Shale & Shells	1705
Shale & Lime	1940
Lime	2040
Lime & Shale	2235
Lime	2300
Lime & Shale	2525
Shale & Lime	3320
Lime & Shale	3435
Shale & Lime	3520
Lime & Shale	3725
Lime	4200
Chert	4278
Cherty Lime	4281
Cherty Lime & Shale	4313
Cherty Lime	4333
Sandy Lime	4340
Sand, Shale & Lime	4360
Rotary T. D.	4360

RECEIVED
 STATE CORPORATION COMMISSION

MAY 2 1962

CONSERVATION DIVISION
 Wichita, Kansas

Formation Tops

Anhydrite	677	+1216
Heebner	3565	-1672
Brown Lime	3744	-1851
Lansing	3763	-1870
Base K. C.	4109	-2216
Mississippian	4202	-2309
Viola	4257	-2364
Simpson Dolomite	4309	-2416
Simpson Shale	4322	-2429
Simpson Sand	4330	-2437
R. T. D.	4360	-2467

I hereby certify that the above and foregoing is a true and correct log of the above described well as shown by the drilling reports.

H-30, INC.

Priscilla M. Ismert
 Priscilla M. Ismert

STATE OF KANSAS)
 SEDGWICK COUNTY) SS:

Subscribed and sworn to before me, a Notary Public, in and for said county and state this 30th day of April, 1962.

Geraldine Hays
 Geraldine Hays, Notary Public

My Commission Expires:
 December 3, 1964.