

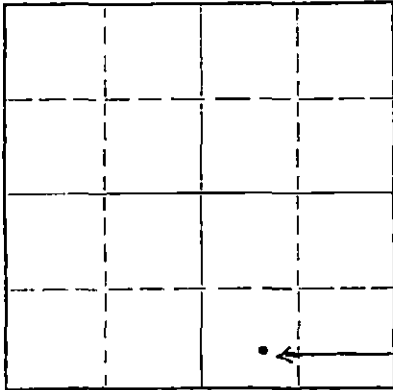
STATE OF KANSAS
STATE CORPORATION COMMISSION

Form CP-4

Give All Information Completely
Make Required Affidavit
Mail or Deliver Report to:
Conservation Division
State Corporation Commission
211 No. Broadway
Wichita, Kansas

WELL PLUGGING RECORD

NORTH

Locate well correctly on above
Section Plat

Pratt County, Sec. 25 Twp. 27S Rge. 13 (X) (W)
Location as "NE/CNW/SW" or footage from lines SW SE
Lease Owner William Gruenerwald & Associates, Inc.
Lease Name Bergner (Washdown) Well No. 1
Office Address Box 909 Colorado Springs, Colorado
Character of Well (completed as Oil, Gas or Dry Hole) Dry Hole
Date well completed August 16 19 68
Application for plugging filed August 15 19 68
Application for plugging approved August 15 19 68
Plugging commenced August 16 19 68
Plugging completed August 16 19 68
Reason for abandonment of well or producing formation Dry Hole

If a producing well is abandoned, date of last production 19____
Was permission obtained from the Conservation Division or its agents before plugging was commenced? Yes

Name of Conservation Agent who supervised plugging of this well Leo F. Massey
Producing formation None Depth to top Bottom Total Depth of Well 4395 Feet
Show depth and thickness of all water, oil and gas formations.

OIL, GAS OR WATER RECORDS

CASING RECORD

FORMATION	CONTENT	FROM	TO	SIZE	PUT IN	PULLED OUT

Describe in detail the manner in which the well was plugged, indicating where the mud fluid was placed and the method or methods used in introducing it into the hole. If cement or other plugs were used, state the character of same and depth placed, from _____ feet to _____ feet for each plug set.

Gunned pits forming heavy mud - filled hole to 300', pushed plug to 300',
cemented with 25 sacks cement, filled hole to 40', bridged with hulls and
cemented with 10 sacks cement, completed @ 11:30 PM 8-16-68

RECEIVED
STATE CORPORATION COMMISSION
NOV 15 1968
CONSERVATION DIVISION
Wichita, Kansas

(If additional description is necessary, use BACK of this sheet)

Name of Plugging Contractor Garvey Drilling Company
Address Route 2, Great Bend, Kansas 67530

STATE OF Kansas, COUNTY OF Barton, ss.

(employee of owner) or (owner or operator) of the above-described well, being first duly sworn on oath, says: That I have knowledge of the facts, statements, and matters herein contained and the log of the above-described well as filed and that the same are true and correct. So help me God.

(Signature)

Route 2, Great Bend, Kansas 67530

(Address)

SUBSCRIBED AND SWORN to before me this 13th day of November, 19 68

My commission expires May 28th, 1969

Notary Public.