


STATE OF KANSAS  
STATE CORPORATION COMMISSION

WELL PLUGGING RECORD

Give All Information Completely  
Make Required Affidavit  
Mail or Deliver Report to:  
Conservation Division  
State Corporation Commission  
211 No. Broadway  
Wichita, Kansas

Pratt County, Sec. 25 Twp. 27S Rge. 13W(E) (W)  
Location as "NE/CNW/SW" or footage from lines NE NE NE  
Lease Owner Tom Palmer  
Lease Name Grier Well No. 1  
Office Address 415 Union Nat'l. Bldg. -- Wichita, Kansas  
Character of Well (completed as Oil, Gas or Dry Hole) dry hole  
Date well completed October 16, 19 56  
Application for plugging filed November 8, 19 56  
Application for plugging approved November 9, 19 56  
Plugging commenced November 23, 19 56  
Plugging completed December 1, 19 56  
Reason for abandonment of well or producing formation dry hole

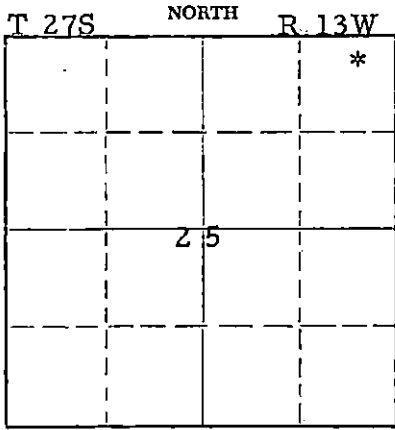

Locate well correctly on above  
Section Plat

If a producing well is abandoned, date of last production \_\_\_\_\_ 19 \_\_\_\_  
Was permission obtained from the Conservation Division or its agents before plugging was commenced? Yes

Name of Conservation Agent who supervised plugging of this well Merle Rives  
Producing formation \_\_\_\_\_ Depth to top \_\_\_\_\_ Bottom \_\_\_\_\_ Total Depth of Well 4400 Feet  
Show depth and thickness of all water, oil and gas formations.

OIL, GAS OR WATER RECORDS

CASING RECORD

FORMATION	CONTENT	FROM	TO	SIZE	PUT IN	PULLED OUT
Simpson	2820' GC salt water	4332	4375	10-3/4" 5-1/2"	324' 4343'	None 3110'
Simpson	180' oil, 90' mud, 300' salt water	4328	4363			

Describe in detail the manner in which the well was plugged, indicating where the mud fluid was placed and the method or methods used in introducing it into the hole. If cement or other plugs were used, state the character of same and depth placed, from \_\_\_\_\_ feet to \_\_\_\_\_ feet for each plug set.

Filled the hole with sand from 4400' to 4315' and ran 5 sacks of cement. Pulled casing up to 1700' and circulated the hole with 45 sacks of jell mud. Pulled rest of casing. Bailed mud to 300', set a 10' rock bridge and ran 25 sacks of cement. Mudded the hole to 25', set a rock bridge and ran 10 sacks of cement to base of cellar. Plugging completed.

RECEIVED  
STATE CORPORATION COMMISSION  
DEC 17 1956  
12-17-56  
CONSERVATION DIVISION  
Wichita, Kansas

(If additional description is necessary, use BACK of this sheet)  
Name of Plugging Contractor West Supply Co., Inc.  
Address Chase, Kansas

STATE OF Kansas, COUNTY OF Sedgwick, ss.  
Tom Palmer (employee of owner) or (owner or operator) of the above-described well, being first duly sworn on oath, says: That I have knowledge of the facts, statements, and matters herein contained and the log of the above-described well as filed and that the same are true and correct. So help me God.  
(Signature) Tom Palmer

(Address) \_\_\_\_\_  
SUBSCRIBED AND SWORN to before me this 14th day of December, 19 56  
Jan 4, 1958  
My commission expires Jan 4, 1958  
William M. Cornick  
Notary Public.

PLUGGING  
SEC 25 T27S R13W  
PLUGGED 11.4.11 E 29