

STATE OF KANSAS  
STATE CORPORATION COMMISSION

WELL PLUGGING RECORD

Give All Information Completely  
Make Required Affidavit  
Mail or Deliver Report to  
Conservation Division  
State Corporation Comm.  
245 North Water  
Wichita, KS 67202

Pratt County, Sec. 25 Twp. 27 Rge. 13W E/W  
Location as "NE/CNW $\frac{1}{4}$ SW $\frac{1}{4}$ " or footage from lines  
NE NE SW

Lease Owner Arrowhead Petroleum, Inc.  
Lease Name Bergner Well No. 1

Office Address Box 8287, Munger Station, Wichita, KS  
Character of Well (Completed as Oil, Gas or Dry Hole)

Dry Hole

Date Well completed 12-18-79 19  
Application for plugging filed 12-18-79 19  
Application for plugging approved 12-18-79 19  
Plugging commenced 12-18-79 19  
Plugging completed 12-18-79 19


Reason for abandonment of well or producing formation  
Dry Hole

If a producing well is abandoned, date of last production  
N/A 19

Was permission obtained from the Conservation Division or  
its agents before plugging was commenced? yes

Name of Conservation Agent who supervised plugging of this well W. T. Owens  
Producing formation Depth to top Bottom Total Depth of Well

Show depth and thickness of all water, oil and gas formations.

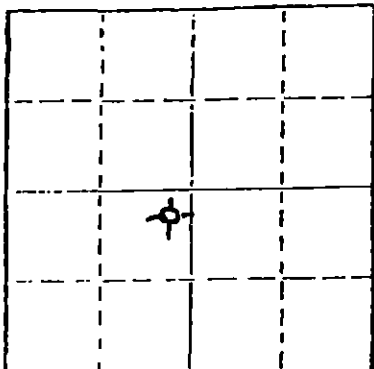

Locate well correctly on above  
Section Plot

OIL, GAS OR WATER RECORDS

CASING RECORD

FORMATION	CONTENT	FROM	TO	SIZE	PUT IN	PULLED OUT
Sand				8 5/8	299'	

Describe in detail the manner in which the well was plugged, indicating where the mud fluid  
was placed and the method or methods used in introducing it into the hold. If cement or other  
plugs were used, state the character of same and depth placed, from feet to  
feet for each plug set.

40 sx 540'  
40 sx 300'  
10 sx 40'  
5 sx RH  
1 sx Water Well

RECEIVED  
STATE CORPORATION COMMISSION

JAN 10 1980 1-10-80

CONSERVATION DIVISION  
Wichita, Kansas

(If additional description is necessary, use BACK of this sheet)  
Name of Plugging Contractor Service Company

STATE OF Kansas COUNTY OF Sedgwick  
Paul A. Seymour, Jr. (employee of owner) or (owner or operator)  
of the above-described well, being first duly sworn on oath, says: That I have knowledge of  
the facts, statements, and matters herein contained and the log of the above-described well  
as filed and that the same are true and correct. So help me God.

(Signature) Paul A. Seymour, Jr.  
Box 8287, Munger Station, Wichita, KS 67208  
(Address)

SUBSCRIBED AND SWORN TO before me this 7th day of January, 19 80

RUTH M. BASSETT  
STATE NOTARY PUBLIC  
Sedgwick County, Kansas  
MAY 30 1983

Ruth M. Bassett  
Ruth M. Bassett Notary Public.

My commission expires

# BIG SPRINGS DRILLING, INC.

P.O. BOX 8287  
MUNGER STATION  
WICHITA, KANSAS 67208

SUITE 29 • 400 NORTH WOODLAWN • (316) 681-1732

January 7, 1980

## DRILLERS LOG

Re: Bergner No. 1  
NE NE SW  
Sec. 25- Twp 27- Rq 13W  
Pratt County, Kansas

OPERATOR: Arrowhead Petroleum, Inc.  
CONTRACTOR: Big Springs Drilling, Inc.  
COMMENCED: 12-10-79  
COMPLETED: 12-18-79

Surface Pipe: 299' w/250 sx Common 2% gel 3% ccl

0	299'	Shale, Clay, and Sand
299'	678'	Clay and Shale
678'	685'	Anhydrite
685'	1727'	Shale
1727'	3815'	Shale and Lime
3815'	4441'	Lime
4441'		RTD


We certify that the above and foregoing is a true and correct copy of the log on the # 1 Bergner located in Pratt County, Kansas.

BIG SPRINGS DRILLING, INC.

  
Paul A. Seymour, Jr.

Subscribed and sworn to before me this 7th day of January, 1980.

  
RUTH M. BASSETT  
STATE NOTARY PUBLIC  
Sedgewick County, Kansas  
My Commission Expires \_\_\_\_\_  
My Appt. Exp. \_\_\_\_\_

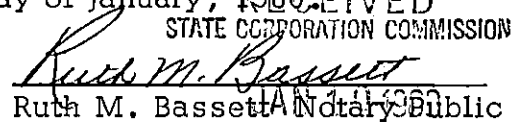RECEIVED  
STATE CORPORATION COMMISSION  
  
Ruth M. Bassett, Notary Public

My Commission Expires \_\_\_\_\_

May 30, 1983

CONSERVATION DIVISION  
Wichita, Kansas