


STATE OF KANSAS
STATE CORPORATION COMMISSION

WELL PLUGGING RECORD

Give All Information Completely
Make Required Affidavit
Mail or Deliver Report to:
Conservation Division
State Corporation Commission
212 No. Market
Wichita, Kansas

Pratt County, Sec. 13 Twp. 27 Rge. (E) 13 (W)

Location as "NE/CNW%SW%" or footage from lines C SW SE SE
Lease Owner The Bovaird Supply Company
Lease Name McGuire "C" Well No. 4
Office Address Box 897, Great Bend, Kansas
Character of Well (completed as Oil, Gas or Dry Hole) oil
Date well completed 19
Application for plugging filed May 10 19 68
Application for plugging approved 19
Plugging commenced May 13 19 68
Plugging completed May 28 19 68
Reason for abandonment of well or producing formation depleted

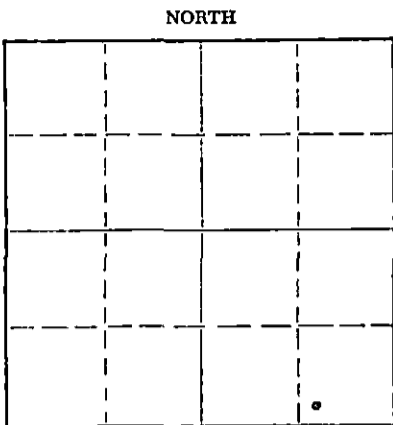

Locate well correctly on above Section Plat

If a producing well is abandoned, date of last production 19
Was permission obtained from the Conservation Division or its agents before plugging was commenced? yes

Name of Conservation Agent who supervised plugging of this well ~~Aronie-V.-Eivans~~ Ralph Warren
Producing formation Depth to top Bottom Total Depth of Well 4363 Feet
Show depth and thickness of all water, oil and gas formations.

OIL, GAS OR WATER RECORDS

CASING RECORD

FORMATION	CONTENT	FROM	TO	SIZE	PUT IN	PULLED OUT
		0	440'	8 5/8"	440'	none
		0	4358 1/2'	5 1/2"	4358 1/2'	1787.67

Describe in detail the manner in which the well was plugged, indicating where the mud fluid was placed and the method or methods used in introducing it into the hole. If cement or other plugs were used, state the character of same and depth placed, from feet to feet for each plug set.

Sand back to 4200' and dumped 5 sacks cement.

Pushed plug to 420', set 10' rock bridge and dumped 25 sacks cement.
Filled hole with mud to 40', set 10' rock bridge and capped hole with 10 sacks cement.

RECEIVED
STATE CORPORATION COMMISSION
JUN 21 1968
CONSERVATION DIVISION
Wichita, Kansas

(If additional description is necessary, use BACK of this sheet)
Name of Plugging Contractor Pipe Pullers, Inc.
Address Box 486, Ellinwood, Kansas

STATE OF Kansas, COUNTY OF Barton, ss.
E. L. Schonhoff (employee of owner) or (owner or operator) of the above-described well, being first duly sworn on oath, says: That I have knowledge of the facts, statements, and matters herein contained and the log of the above-described well as filed and that the same are true and correct. So help me God.

(Signature) E. L. Schonhoff
Ellinwood, Kansas (Address)

SUBSCRIBED AND SWORN TO before me this 7th day of June, 19 68

My commission expires July 7, 1968

Notary Public.

DRILLERS LOG

McGuire C #4

Elevation: 1896 DF

Loc: C-SW-SE-SE

Casing: 8-5/8" set at 440'
w/300 sacks Posmix.

Sec: 13-27-13W

5 1/2" set @ 4358.50'

Pratt County, Kansas.

w/ 75 sacks common

Operator: Cooperative Refinery

Comm: 8-28-53 Comp: 9-13-53

Contractor: Cooperative Refinery

Total Depth: 4359'

From	To	Formation
0	410	Surface
410	440	Red Bed Shale and Shells
440	860	Red Bed Shale and Sand
860	870	Anhydrite
870	1745	Shale and Shells
1745	1925	Shale and Lime
1925	2050	Lime and Shells
2050	3220	Lime and Shale
3220	3275	Lime
3275	3380	Lime and Shale
3380	3440	Lime
3440	3555	Lime and Shale
3555	3814	Shale and Lime
3814	4213	Lime
4213	4260	Lime and Chert
4260	4288	Chert Lime and Shale
4288	4345	Sand and Shale
4345	4363	Lime
4363		R.T.D.

RECEIVED
STATE CORPORATION COMMISSION
MAY 14 1968
CONSERVATION DIVISION
Wichita, Kansas

(STATE OF KANSAS)
(COUNTY OF BARTON)

I hereby certify that the above is a true and correct copy of the log on the McGuire C #4 well, located C-SW SE SE of Section 13-27-13W, Pratt County, Kansas

L. M. Collins

Subscribed and sworn to before me this 21 day of Sept., 1953.

Donald E. ...

My commission expires: 8-12-57