


STATE OF KANSAS
STATE CORPORATION COMMISSION

Give All Information Completely
Make Required Affidavit
Mail or Deliver Report to:
Conservation Division
State Corporation Commission
212 No. Market
Wichita, Kansas

WELL PLUGGING RECORD

NORTH

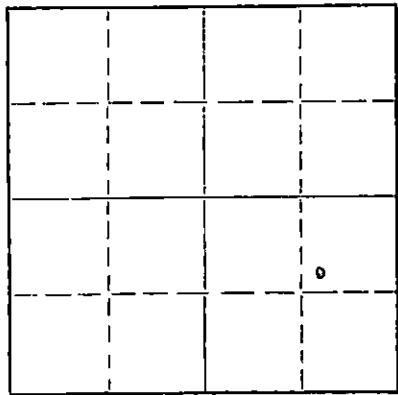

Locate well correctly on above
Section Plat

Pratt County, Sec. 13 Twp. 27 Rge. (E) 13 (W)
Location as "NE/CNW%SW%" or footage from lines SW NE SE
Lease Owner The Bovaird Supply Company
Lease Name McGuire "C" Well No. 3
Office Address Box 897, Great Bend, Kansas
Character of Well (completed as Oil, Gas or Dry Hole) oil
Date well completed _____ 19____
Application for plugging filed May 10 19 68
Application for plugging approved _____ 19____
Plugging commenced June 4 19 68
Plugging completed June 9 19 68
Reason for abandonment of well or producing formation depleted
If a producing well is abandoned, date of last production _____ 19____
Was permission obtained from the Conservation Division or its agents before plugging was commenced? yes

Name of Conservation Agent who supervised plugging of this well Ralph Warren
Producing formation _____ Depth to top _____ Bottom _____ Total Depth of Well 4362 Feet
Show depth and thickness of all water, oil and gas formations.

OIL, GAS OR WATER RECORDS

CASING RECORD

FORMATION	CONTENT	FROM	TO	SIZE	PUT IN	PULLED OUT
		0	430'	8 5/8"	430'	none
		0	4357'	5 1/2"	4357'	3002.85

Describe in detail the manner in which the well was plugged, indicating where the mud fluid was placed and the method or methods used in introducing it into the hole. If cement or other plugs were used, state the character of same and depth placed, from _____ feet to _____ feet for each plug set.

Sand back to 4300' and dumped 5 sacks cement.
Pushed plug to 400', set 10' rock bridge and dumped 25 sacks cement.
Filled hole with mud to 40', set 10' rock bridge and capped hole with 10 sacks cement.


RECEIVED
STATE CORPORATION COMMISSION
JUN 21 1968
CONSERVATION DIVISION
Wichita, Kansas

(If additional description is necessary, use BACK of this sheet)
Name of Plugging Contractor Pipe Pullers, Inc.
Address Box 486, Ellinwood, Kansas

STATE OF Kansas, COUNTY OF Barton, ss.
E. L. Schonhoff (employee of owner) or (~~owner or operator~~) of the above-described well, being first duly sworn on oath, says: That I have knowledge of the facts, statements, and matters herein contained and the log of the above-described well as filed and that the same are true and correct. So help me God.

(Signature) E. L. Schonhoff
Ellinwood, Kansas (Address)

Subscribed and Sworn to before me this 11th day of June, 19 68

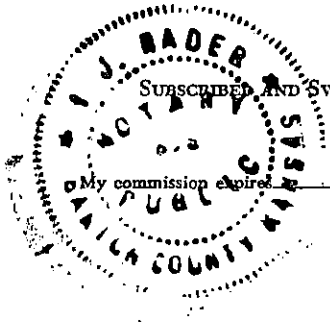

July 7, 1968

Notary Public.

DRILLERS LOG

RECEIVED
STATE CORPORATION COMMISSION
MAY 14 1968
CONSERVATION DIVISION
Wichita, Kansas

McGuire C #3 Elevation: 1901 D. F.
Casing: 430' of 8-5/8" w/ 300
sx Posmix. Set 5 1/2" @
4357' w/150 sx common.
Pratt County, Kansas. (435' 15.5# JS and 3926'
of 14# JS)

Operator: Cooperative Refinery Comm: 8-8-53 Comp: 8-25-53
Contractor: Cooperative Refinery Total Depth: 4362'

From	To	Formation
0	150	Surface
150	431	Red Bed, Shale and Shells
431	1170	Sand, Shale and Shells
1170	1590	Shale and Shells
1590	1880	Shale and Lime
1880	1985	Lime and Shells
1985	3090	Lime and Shale
3090	3170	Lime
3170	3325	Lime and Shale
3325	3570	Lime
3570	3728	Shale and Lime
3728	3790	Lime
3790	3830	Chalky Lime - Lime
3830	4225	Lime
4225	4260	Lime, Shale and Chert
4260	4284	Lime and Shale
4284	4298	Dolomite
4298	4304	Shale
4304	4344	Sand
4344	4362	Shale
4362		R. T. D.

STATE OF KANSAS
COUNTY OF BARTON SS

I hereby certify that the above is a true and correct copy of the log on the McGuire C #3 well, located SW-NE-SE of Section 13-27-13, Pratt County, Kansas.

L. M. Collins

Subscribed and sworn to before me this 28 day of August, 1953.

Donald E. Hunt
Notary Public

My commission expires: 1957 Aug 11