


STATE OF KANSAS
STATE CORPORATION COMMISSION

WELL PLUGGING RECORD

Give All Information Completely
Make Required Affidavit
Mail or Deliver Report to
Conservation Division
State Corporation Comm.
245 North Water
Wichita, KS 67202

Pratt County, Sec. 13 Twp. 27S Rge. 13W E/W
Location as "NE/CNW/SW" or footage from lines
SE NE SE

Lease Owner Sinclair & Immich, Inc.
Lease Name McGuire Well No. 1
Office Address 200 E. First St. 307 Farmers & Bankers Bldg., Wichita, KS 67202
Character of Well (Completed as Oil, Gas or Dry Hole)

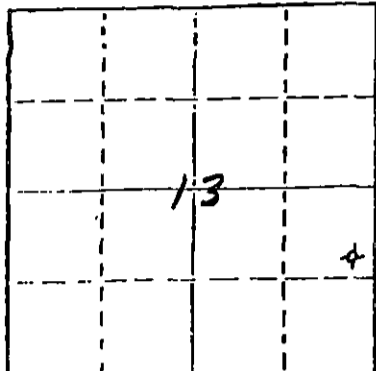

Locate well correctly on above
Section Plot

Dry Hole
Date Well completed May 30, 19 81
Application for plugging filed May 30, 19 81
Application for plugging approved May 30, 19 81
Plugging commenced May 30, 19 81
Plugging completed May 30, 19 81
Reason for abandonment of well or producing formation
Dry Hole

If a producing well is abandoned, date of last production 19

Was permission obtained from the Conservation Division or its agents before plugging was commenced? Yes

Name of Conservation Agent who supervised plugging of this well Wm. T. Owen
Producing formation Depth to top Bottom Total Depth of Well 4405'
Show depth and thickness of all water, oil and gas formations.

OIL, GAS OR WATER RECORDS

CASING RECORD

FORMATION	CONTENT	FROM	TO	SIZE	PUT IN	PULLED OUT
		0'	452'	8-5/8"	445.77'	None

Describe in detail the manner in which the well was plugged, indicating where the mud fluid was placed and the method or methods used in introducing it into the hold. If cement or other plugs were used, state the character of same and depth placed, from feet to feet for each plug set.

Plugged with 30 sacks cement at 620';
30 sacks cement at 450'; 10 sacks cement
at 40'; and 10 sacks cement in rat hole.

(If additional description is necessary, use BACK of this sheet)

Name of Plugging Contractor Halliburton Cementing Co.


STATE OF KANSAS COUNTY OF SEDGWICK, ss.
John D. Knightley Agent (employee of owner) or (owner or operator)
of the above-described well, being first duly sworn on oath, says: That I have knowledge of the facts, statements, and matters herein contained and the log of the above-described well as filed and that the same are true and correct. So help me God.

(Signature) [Signature]
221 S. Broadway, Wichita, Kansas 67202
(Address)

SUBSCRIBED AND SWORN TO before me this 2nd day of June, 19 81

[Signature]
Notary Public.

My commission expires March 12, 1983

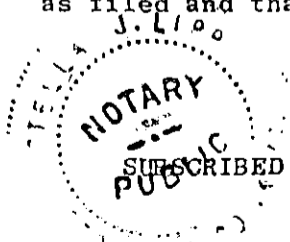

Sinclair & Immich, Inc.
307 Farmers & Bankers Bldg.
200 E. First St.
Wichita, Kansas 67202

McGuire #1
SE NE SE Sec. 13-27S-13W
Pratt County, Kansas

Contractor: D. R. Lauck Oil Company, Inc.
221 S. Broadway, Suite 400
Wichita, Kansas 67202

Commenced: May 20, 1981
Completed: May 30, 1981

Drillers Log

Sand & Top Soil	160
Red Bed	1328
Shale & Shells	3320
Lime & Shale	3805
Lime	4323
Lime & Shale	4335
Lime	4405 RTD