

STATE OF KANSAS
STATE CORPORATION COMMISSION


WELL PLUGGING RECORD

OR
FORMATION PLUGGING RECORD

Strike out upper line
when reporting plug-
ging of formations.

Give All Information Completely
Make Required Affidavit
Mail or Deliver Report to:
Conservation Division
State Corporation Commission
800 Bitting Building
Wichita, Kansas

NORTH

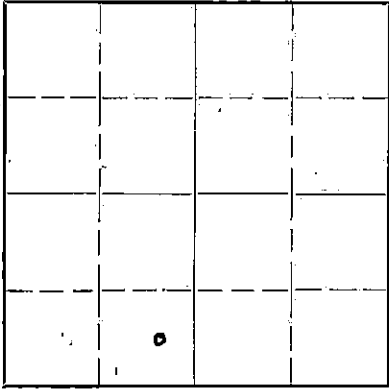

Locate well correctly on above
Section Plat

Pratt County, Sec. 2, Twp. 27-S Rge. (E) 13 (W)
Location as "NE 1/4 NW 1/4 SW 1/4" or footage from lines 100' E. of E. SE 1/4 SW 1/4
Lease Owner Lion Oil Refining Co.
Lease Name Baughman Well No. 1
Office Address El Dorado, Arkansas
Character of Well (completed as Oil, Gas or Dry Hole) Dry Hole
Date well completed Aug. 13, 1943
Application for plugging filed Aug. 13, 1943
Application for plugging approved Aug. 13, 1943
Plugging commenced Aug. 13, 1943
Plugging completed Aug. 21, 1943
Reason for abandonment of well or producing formation Dry Hole

If a producing well is abandoned, date of last production 19
Was permission obtained from the Conservation Division or its agents before plugging was com-
menced? Yes

Name of Conservation Agent who supervised plugging of this well C. J. Alexander
Producing formation Depth to top Bottom Total Depth of Well 4395 Feet
Show depth and thickness of all water, oil and gas formations.

OIL, GAS OR WATER RECORDS

CASING RECORD

Formation	Content	From	To	Size	Put In	Pulled Out
				5 1/2"	4273'	2500'
				8 5/8"	302'	none

Describe in detail the manner in which the well was plugged, indicating where the mud fluid was placed and the method or methods used in introducing it into the hold. If cement or other plugs were used, state the character of same and depth placed, from feet to feet for each plug set.

Cemented from 4395' - 4259', using 15 sacks cement.
Mud from 4259' - 305'. Bridge set 302' using 10 sacks cement. Bridge set at 20' using 5 sacks cement.

PLUGGING
FILE SEC 2 27R13W
BOOK PAGE 88 LNS 4

9-3-43
SEP 3

(If additional description is necessary, use BACK of this sheet)
Correspondence regarding this well should be addressed to Lion Oil Refining Co.
Address El Dorado, Arkansas Exchange Bldg.

STATE OF Kansas COUNTY OF Reno, ss.
Vernon Hayes (employee of owner) or (owner or operator) of the above-described well,
being first duly sworn on oath, says: That I have knowledge of the facts, statements, and matters herein contained and the log of the above-
described well as filed and that the same are true and correct. So help me God.

(Signature) Vernon Hayes

SUBSCRIBED AND SWORN to before me this 2nd day of Sept, 1943

My commission expires Nov-4, 1943
Ruth Rickardwell Notary Public.

LION OIL REFINING COMPANY
Eldorado, Arkansas

Boughner Well No. 1

660 ft N & 550 ft W of SW corner of the SW $\frac{1}{4}$ of Sec. 2, Twp. 27S, Rge. 13W, Pratt County, Kansas.

Contractor: The R. W. Hine Drilling Company

Commenced: May 31, 1943

Completed: Aug. 20, 1943

LOG	
Sand & Shale	Top- 250
Red Bed	250- 304 8 5/8" casing cemented at 300'
Red Bed	304-1010
Shale & Shells	1010-1905
Lime	1905-2045
Sandy Lime	2045-2075
Lime	2075-2420
Shale	2420-2475
Shale Stickey	2475-2540
Shale & Lime	2540-3129
Lime	3129-3910
Lime & Shale	3910-3970
Lime	3970-4045
Lime & Shale	4045-4095
Lime	4095-4130
Chert	4130-4135
Chert & Lime	4135-4144
Lime, Shale & Chert	4144-4167
Lime & Chert	4167-4168
Shale	4168-4177
Chert & Lime	4177-4265
Shale	4265-4273 5 1/2" casing at 4273'
Sand	4273-4288 Drill Stem Test at 4276' - show
Cherty Lime	4288-4316 of oil.
Lime	4316-4325
Shale	4325-4355
Lime Coning	4355-4358
Shale	4358-4368
Lime	4368-4375
Paradise Iron	4375-4376
Lime	4376-4395 Total Depth 4386'

State of Kansas)
County of Barton) ss.

I, C. H. Todd, do hereby certify that the above is a true and correct copy of the log of Boughner Well No. 1, located 660 ft N & 550 ft W of SW corner of the SW $\frac{1}{4}$ of Section 2, Township 27S, Range 13W, Pratt County, Kansas.

C. H. Todd

Sworn to and subscribed before me this 31 day of August, 1943.

C. O. Deighton

My commission expires December 4th 1943

FILE 2-27-13W
PAGE 88 LINE 4